IREDELL COUNTY HEALTH DEPARTMENT

Statesville Phone TR 3-7271 Mooresville Phone NO 3-1271

PERMIT TO INSTALL SEPTIC TANK

Permit No. 119 Permit Date _____ 19__

Owner Gene Fay Address _____

Installed By Gene Fay (Hoke) Address _____


Location of Property Northmont Sub-division Lot #80. House with Big trees in yard

Tank		Capacity		Length of Lines		Fixtures	
Block	( )	1000	( )	225'	( )	No. of Baths	(2)
Precast	(✓)	1250	(✓)	250'	( )	Dishwasher	( )
		1500	( )	Other 255'		Garbage Grdr.	( )
		Other _____				Other _____	

NOTIFY HEALTH DEPARTMENT AT LEAST EIGHT HOURS BEFORE TANK IS TO BE INSPECTED.

Final Inspection 6-9-1972 Approved (✓) Disapproved ( )

Remarks Community water supply

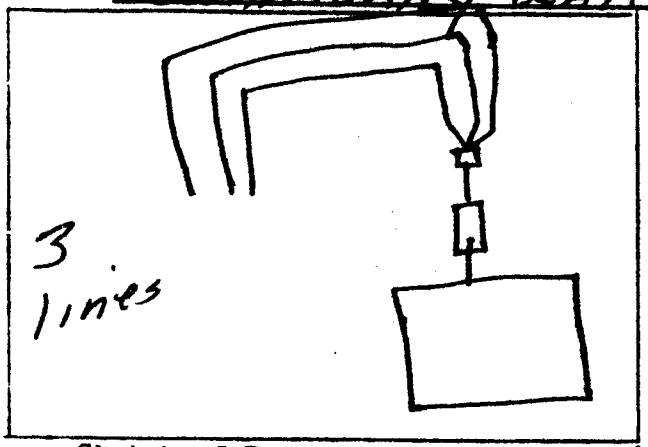

Sketch of Installation

street

Cuss S. Hale

Sanitarian