IREDELL COUNTY HEALTH DEPARTMENT

Statesville Phone TR 3-7271 Mooresville Phone NO 3-1271

PERMIT TO INSTALL SEPTIC TANK

Permit No. 111 Permit Date _____ 19___

Owner Gene Fay Address _____

Installed By Robert Hoke Address _____


Location of Property Northmont Acres Lot # 8 (Eight)

Tank		Capacity		Length of Lines		Fixtures	
Block	( )	1000	( )	225'	( )	No. of Baths	(2)
Precast	(✓)	1250	(✓)	250'	( )	Dishwasher	(/)
		1500	( )	Other 254		Garbage Grdr.	(/)
		Other				Other	

NOTIFY HEALTH DEPARTMENT AT LEAST EIGHT HOURS BEFORE TANK IS TO BE INSPECTED.

Final Inspection 4-10 1973 Approved (✓) Disapproved ( )

Remarks _____

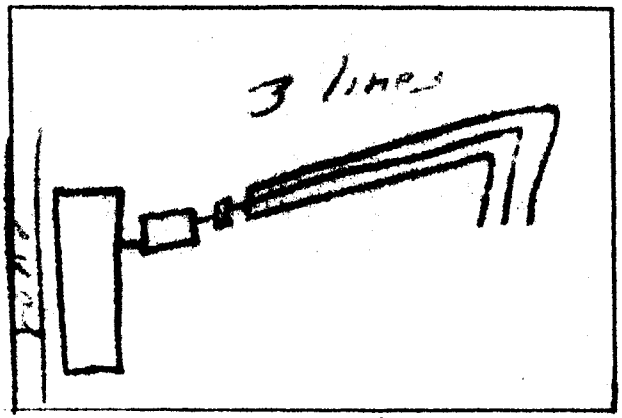

Sketch of Installation

Sanitarian