IREDELL COUNTY HEALTH DEPARTMENT

Statesville Phone TR 3-7271 Mooresville Phone No. 664-

PERMIT TO INSTALL SEPTIC TANK

Permit No. 318 Permit Date 4-19 1973

Owner Robert Brawley, Bldr. Address Statesville N.C.

Installed By Lackey Bro. Address Stony Point N.C.


Location of Property Northmont Acres
Lot # 9. House on R.

Tank		Capacity		Length of Lines		Fixtures	
Block	( )	1000	(✓)	225'	( )	No. of Baths	(3)
Precast	(✓)	1250	( )	250'	( )	Dishwasher	(✓)
		1500	( )	Other 255		Garbage Grdr.	( )
		Other				Other	

NOTIFY HEALTH DEPARTMENT AT LEAST EIGHT HOURS BEFORE TANK IS TO BE INSPECTED.

Final Inspection 4-19 1973 Approved (✓) Disapproved ( )

Remarks Community Water

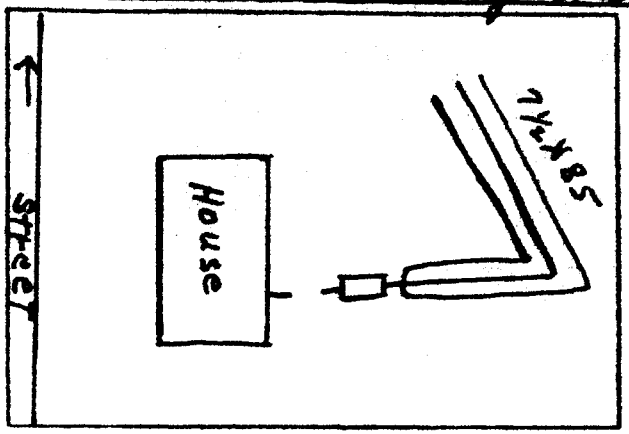

Sketch of Installation

E. A. Stevenson
Sanitarian