IREDELL COUNTY HEALTH DEPARTMENT

Statesville Phone TR 3-7271 Mooresville Phone NO 3-1271

PERMIT TO INSTALL SEPTIC TANK

Permit No. 26 Permit Date 8-1 1972

Owner Gene Fay Address

Installed By Fay (R. Hoke) Address


Location of Property Northmont Sub-division Lot # 87

Tank		Capacity		Length of Lines		Fixtures	
Block	( )	1000	( )	225'	( )	No. of Baths	(2½)
Precast	(✓)	1250	(✓)	250'	( )	Dishwasher	( )
		1500	( )	Other 255		Garbage Grdr.	(✓)
		Other				Other	

NOTIFY HEALTH DEPARTMENT AT LEAST EIGHT HOURS BEFORE TANK IS TO BE INSPECTED.

Final Inspection 8-1-1972 Approved (✓) Disapproved ( )

Remarks Little deep but good soil

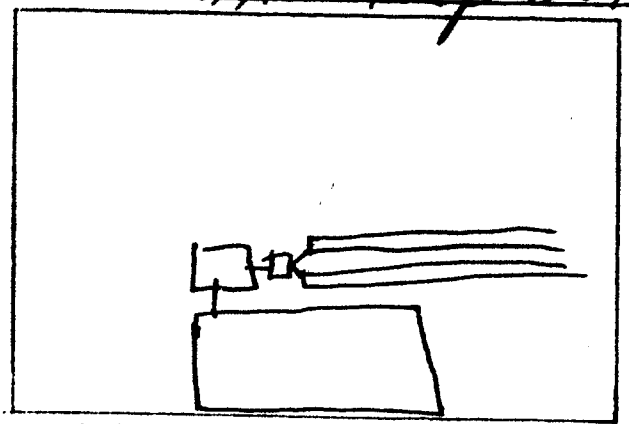

Sketch of Installation

street

Gene S. Hall

Sanitarian