# IREDELL COUNTY HEALTH DEPARTMENT

STATESVILLE 704-878-5305 MOORESVILLE 704-664-5281

## IMPROVEMENT PERMIT / AUTHORIZATION TO CONSTRUCT / OPERATION PERMIT / EXISTING SYSTEM INSPECTION

PERMIT# 086042 PIN# 4735 08 1353 DATE 11-12-99

OWNER OR CONTRACTOR JOSE GONZALEZ PHONE: Business Home 924-9583

ADDRESS 140 BROOK HOLLOW DR, STATESVILLE NC 28625

LOCATION NC 115 NORTH, TL OLD WILKESBORO ROAD, TR CREEKSIDE DR, TR HEAVENLY DR, 2ND LOT ON (L)

SUBDIVISION NORTHMONT BLOCK / SECTION LOT 63 LOT AREA 1.0 ACRE SITE CLASS PS DESIGN FLOW 360 L.T.A.R. 0.40 GPD/FT²

Septic Tank: 1000 Gallons; STB Date 6-25-00
Pump Tank: Gallons; PT Date
Pump Make: Model Serial No.
Nitrification Field: No Fields 1 Square Feet 900 Linear Feet 300
No Lines Four Trench Width 36" Max Trench Bottom Depth 36" Gravel Depth 12"

☑ New System ☐ Repair System Type: I (II) III IV V VI
System Description: CONVENTIONAL GRAVITY
Repair System Description: FPBPS GRAVITY/PUMP
Maintenance Agreement Required: ☐ Yes ☑ No
☐ Slab ☑ Crawl Space ☐ Basement w/plumbing ☐ Basement wo/plumbing


☐ House/Mod. Home No. Bedrooms 3
☐ Mobile Home No. Bathrooms 2
☐ Business No. Employees
☐ Other

Water Supply: ☐ Individual ☑ Public ☐ Community

Comments/Conditions: INSTALL DRAINLINES EACH ON CONTOUR 36" DEEP

Comments/Conditions:

INITIAL SITE SKETCH

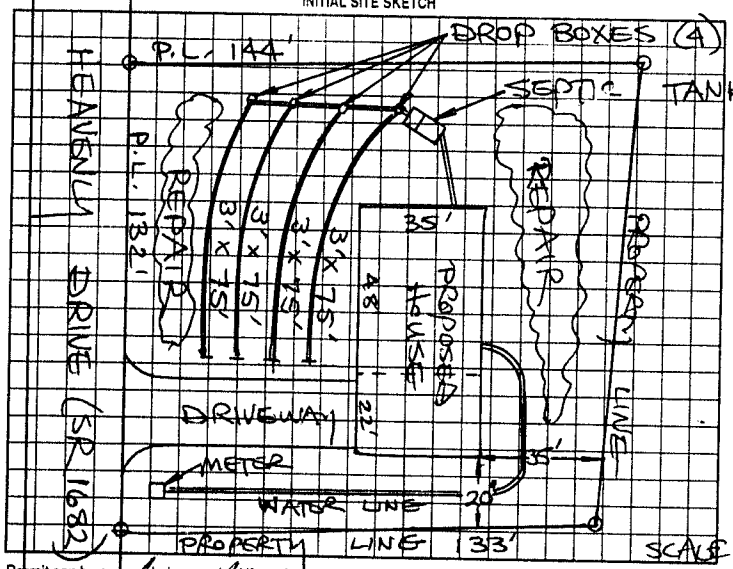


AS BUILT SKETCH

Installed as shown

Permit can be suspended or revoked if any false information is supplied toward securing the permit/any unauthorized changes are made to the site/any unauthorized changes are made in the installation of the system. Improvement Permit with plat valid without expiration. Improvement Permit with site plan valid for sixty months. Authorization to Construct is valid for a period equal to that of Improvement Permit – not to exceed sixty months.

Signed: [signature] date 11-12-99 Installed by: Tommy Frye

Improvement Permit by: STEVE HEDRICK date 11-12-99 Operation Permit by: [signature] date 10-24-00

Authorization to Construct by: STEVE HEDRICK date 11-12-99 Existing System Inspection by: date

HEALTH DEPT. COPY: WHITE OWNER COPY (FINAL): YELLOW OWNER COPY (INITIAL): PINK