IREDELL COUNTY HEALTH DEPARTMENT

STATESVILLE 704-878-5305 MOORESVILLE 704-664-5281

IMPROVEMENT PERMIT / AUTHORIZATION TO CONSTRUCT / OPERATION PERMIT / EXISTING SYSTEM INSPECTION

DATE 11-17-99

PERMIT# REPAIR PIN#

OWNER OR CONTRACTOR EDGAR OSORIO PHONE: Business Home 872-2607

ADDRESS 123 GAYMONT DRIVE, STATESVILLE NC 28625

LOCATION NC 115 N, TL OLD WILKESBORO RD, TR NORTHMONT DRIVE, TL GAYMONT DRIVE, HOUSE ON LEFT AT #123

SUBDIVISION NORTHMONT BLOCK / SECTION LOT LOT AREA LIMITED SITE CLASS AS DESIGN FLOW 480 L.T.A.R. EXISTING

Septic Tank: 1000 Gallons STB Date

Pump Tank: EXISTING Gallons PT Date

Pump Make: Model Serial No.

Nitrification Field: No Fields 1 Square Feet 300 Linear Feet 100

No Lines 1 Trench Width 36" Max Trench Bottom Depth 8/12 LOW Gravel Depth 24"

☐ New System ☑ Repair System Type: I, II, III, IV, V, VI

System Description: CONVENTIONAL GRAVITY

Repair System Description: CONV. GRAVITY

Maintenance Agreement Required: ☐ Yes ☑ No

☑ House/Mod. Home ☐ Mobile Home ☐ Business ☐ Other

No. Bedrooms 4 No. Bathrooms 3 No. Employees


☐ Slab ☑ Crawl Space ☐ Basement w/plumbing ☐ Basement wo/plumbing

Water Supply: ☐ Individual ☑ Public ☐ Community


Comments/Conditions: ① EXISTING LINES ARE TOO DEEP, INSTALL NEW 3'x100' LINES AS SHALLOW AS POSSIBLE USING 24" STONE ② INSTALL NEW DISTRIBUTION BOXES AND SANITARY TEE IN TANK ③ REMOVE MAPLE TREE

Comments/Conditions: THIS PERMIT SERVES AS NOTICE OF VIOLATION, SYSTEM MUST BE REPAIRED BY 12-18-99 (THIRTY DAYS)

INITIAL SITE SKETCH

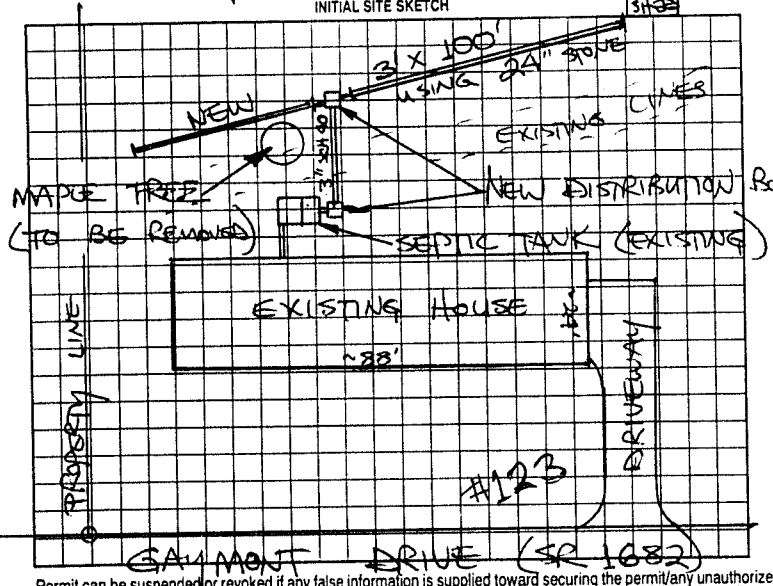

AS BUILT SKETCH

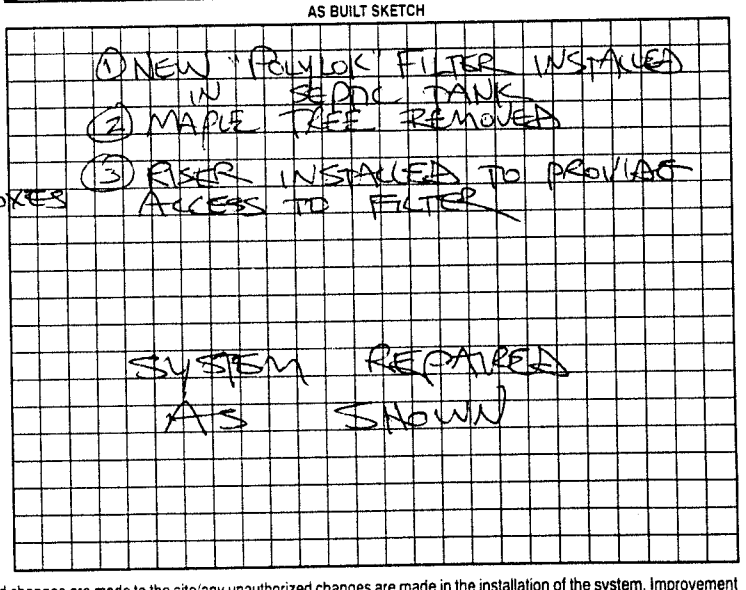

Permit can be suspended or revoked if any false information is supplied toward securing the permit/any unauthorized changes are made to the site/any unauthorized changes are made in the installation of the system. Improvement Permit with plat valid without expiration. Improvement Permit with site plan valid for sixty months. Authorization to Construct is valid for a period equal to that of Improvement Permit – not to exceed sixty months.

Signed: [signature] Mendez date 11-16-99 Installed by: C & W GRADING

Improvement Permit by: STEVE HEDRICK date 11-17-99 Operation Permit by: STEVE HEDRICK date 12-20-99

Authorization to Construct by: STEVE HEDRICK date 11-17-99 Existing System Inspection by: date

HEALTH DEPT. COPY: WHITE OWNER COPY (FINAL): YELLOW OWNER COPY (INITIAL): PINK