IREDELL COUNTY HEALTH DEPARTMENT

Statesville Phone TR 3-7271 Mooresville Phone NO 3-1271

PERMIT TO INSTALL SEPTIC TANK

Permit No. 200 Permit Date 7-19 1972

Owner Gene Fox Address Statesville

Installed By Robert Hoke Address Statesville


Location of Property North Mont - Off of 115 - Lot #86

Tank		Capacity		Length of Lines		Fixtures	
Block	( )	1000	( )	225'	( )	No. of Baths	(2)
Precast	( )	1250	(✓)	250'	( )	Dishwasher	(✓)
		1500	( )	Other 255		Garbage Grdr.	(✓)
		Other				Other	

NOTIFY HEALTH DEPARTMENT AT LEAST EIGHT HOURS BEFORE TANK IS TO BE INSPECTED.

Final Inspection 7-19 1972 Approved (✓) Disapproved ( )

Remarks Community water

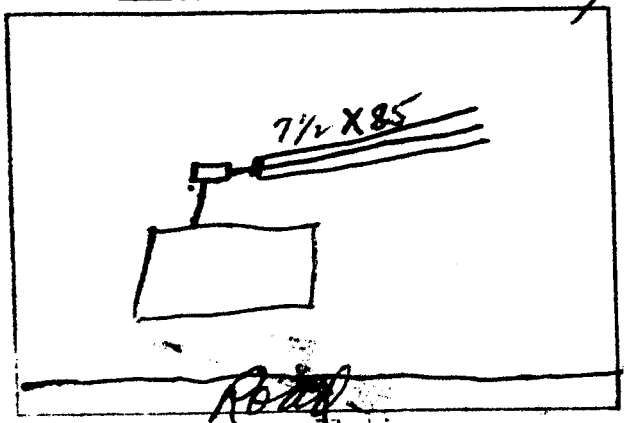

Sketch of Installation

E. P. Stevenson

Sanitarian