IREDELL COUNTY HEALTH DEPARTMENT

Statesville Phone TR 3-7271 — Mooresville Phone NO 3-1271

PERMIT TO INSTALL SEPTIC TANK

Permit No. 17 — Permit Date 7-28 1972

Owner BLDR. R.E. Foy — Address STATESVILLE, N.C.

Installed By Robert Hoke — Address STATESVILLE, N.C.

Location of Property OLD Wilkesboro Rd.


NORTHMONT — Lot # 82

Tank		Capacity		Length of Lines		Fixtures	
Block	( )	1000	( )	225'	( )	No. of Baths	(2)
Precast	(✓)	1250	(✓)	250'	(-)	Dishwasher	(1)
		1500	( )	Other 255		Garbage Grdr.	(1)
		Other				Other	

NOTIFY HEALTH DEPARTMENT AT LEAST EIGHT HOURS BEFORE TANK IS TO BE INSPECTED.

Final Inspection 7-28 1972 — Approved (✓) Disapproved ( )

Remarks Community WATER Supply

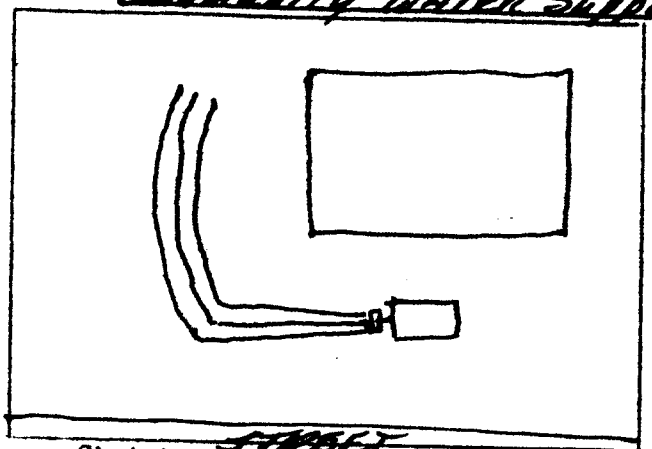

Sketch of Installation

E.H.R. Ann Hall

Sanitarian