IREDELL COUNTY HEALTH DEPARTMENT

STATESVILLE 704-878-5305 MOORESVILLE 704-664-5281

IMPROVEMENT PERMIT / AUTHORIZATION TO CONSTRUCT / OPERATION PERMIT / EXISTING SYSTEM INSPECTION

PERMIT# REPAIR PIN# 4735-08-4307 WES LYTTON DATE 5-31-06

OWNER OR APPLICANT DUPREE & DELORES CHAPMAN PHONE: Business 704-902-8010 Home

ADDRESS 137 GAYMONT CIRCLE STATESVILLE NC 28625

LOCATION 115 N (L) OLD WILKESBORO (R) NORTHMONT (L) GAYMONT AT END IN CUL-DE-SAC - 137 Baymont Circle

SUBDIVISION NORTHMONT BLOCK / SECTION LOT 84 LOT AREA 20,033.5 SF SITE CLASS. PS DESIGN FLOW L.T.A.R. EXISTING

Septic Tank: EXISTING Gallons: STB Date

Pump Tank: Gallons: PT Date

Pump Make: Model Serial No.

Nitrification Field: No Fields 1 Square Feet Linear Feet 200'

No Lines 3 Trench Width 36" Max Trench Bottom Depth N/A

☒ New System ☒ Repair ☐ Expansion System Type: I ☒ II III IV V VI

System Description: 60% low

Repair System Description:

Maintenance Agreement Required: ☐ Yes ☐ No

☒ House/Mod. Home No. Bedrooms

☐ Mobile Home No. Persons

☐ Business No. Employees

☐ Other

Water Supply: ☐ Individual ☒ Public ☐ Community


Gravity ☐ Pressure ☐ Slab ☐ Crawl Space ☐ Basement w/plumbing ☐ Basement wo/plumbing

Comments:/Conditions: (1) INSTALL 3 LINES TOTALING 200' USING 24" STONE. (2) INSTALL BOLL AW VALVE (3) THIS PERMIT SERVES AS NOTICE OF VIOLATION AND MUST BE

Comments:/Conditions: INSTALLED WITHIN 30 DAYS.

INITIAL SITE SKETCH

1" = 40'

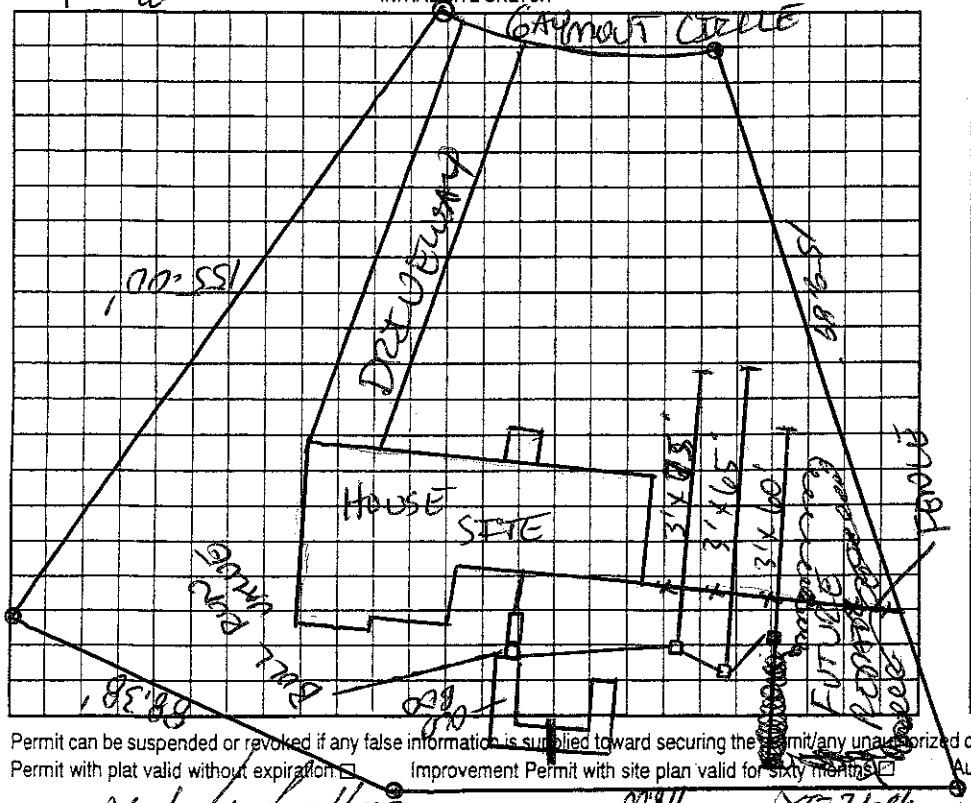

AS BUILT SKETCH

INSTALLED AS PER AW

#1 = NEW LINES

#2 = OLD LINES

SWITCH EVERY 6 MONTHS

Permit can be suspended or revoked if any false information is supplied toward securing the permit/any unauthorized changes are made to the site/any unauthorized changes are made in the installation of the system. Improvement Permit with plat valid without expiration ☐ Improvement Permit with site plan valid for sixty months ☐ Authorization to Construct is valid for a period equal to that of Improvement Permit – not to exceed sixty months.

Signed: date 5-31-06

Improvement ~~Permit~~ by: date 5-31-06

Authorization to Construct by: date 5-31-06

Installed by: WES LYTTON

Operation Permit by: date 5-31-06

Existing System Inspection by: date

HEALTH DEPT. COPY: WHITE OWNER COPY (FINAL): YELLOW OWNER COPY (INITIAL): PINK