IREDELL COUNTY HEALTH DEPARTMENT

Statesville Phone TR 3-7271 Mooresville Phone NO 3-1271

PERMIT TO INSTALL SEPTIC TANK

Permit No. 16 Permit Date 7-27 1972

Owner RE(GENE) Foy Address STATESVILLE, N.C.

Installed By Robert Hoke Address Statesville, NC

Location of Property OLD Highway #115-


NORTHMONT- Lot #84

Tank		Capacity		Length of Lines		Fixtures	
Block	( )	1000	( )	225'	( )	No. of Baths	(2½)
Precast	(✓)	1250	(✓)	250'	( )	Dishwasher	(1)
		1500	( )	Other 265		Garbage Grdr.	(1)
		Other				Other	

NOTIFY HEALTH DEPARTMENT AT LEAST EIGHT HOURS BEFORE TANK IS TO BE INSPECTED.

Final Inspection 7-27 1972 Approved (✓) Disapproved ( )

Remarks Community WATER Supply

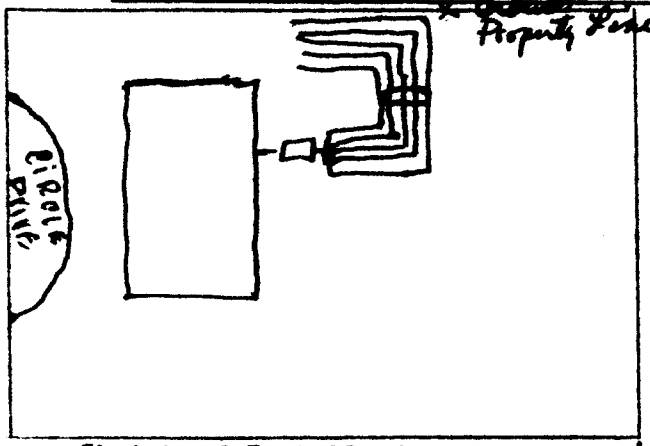

Sketch of Installation

Sanitarian