MW

ICHD - ENVIRONMENTAL HEALTH DIVISION

Statesville Office (704) 878-5305 Mooresville Office (704) 660-3625 PERMIT # AP2022-5223

SEPTIC: IMPROVEMENT PERMIT / AUTHORIZATION TO CONSTRUCT / OPERATION PERMIT / EXISTING SYSTEM / Repair PIN # 4735 --08 --5301

APPLICANT/OWNER: Brian Ouellette APPLICANT ADDRESS: 136 Gaymont Cir, Statesville

SITE ADDRESS: 136 Gaymont Cir, Statesville 28625 PHONE: 203-841-6710 ALT. PHONE -

SITE DIRECTIONS: 115 N - Old Wilkesboro - Northmont - Gaymont SAP CONTROLLED: ☐ YES ☐ NO


SUBDIVISION: Northmont SECTION: - LOT # 83 LOT AREA: DESIGN FLOW: EX L.T.A.R.: EX

Septic Tank	1000	(gal)	STB 760	Date	8/29/22	☐ New System	☒ Repair	☐ Expansion	System Type: I (II) III IV V VI	☒ Residence	No. Bedrooms 3
Pump Tank		(gal)	PT	Date		System Description:				☐ Business	No. Persons 6
Pump Make			Model	Serial #		Repair System Description:	Tank replacement			☐ Other	No. Employees
# Nitrification Fields	EX		# Lines EX	Linear Ft	EX	Maintenance Agreement Required:	☐ YES	☒ NO		☐ Slab	☐ Crawl Space
Trench Width	EX		Trench Bottom Depth(Low side)		EX	Gravel Depth EX	☒ GRAVITY	☐ PRESSURE		☒ Basement w/plumbing	☐ Basement w/o plumbing

Water Supply: ☐ Private ☒ Public ☐ Community

Comments / Conditions: Pump, crush, & fill old septic tank Replace distribution if necessary.

INITIAL SITE SKETCH

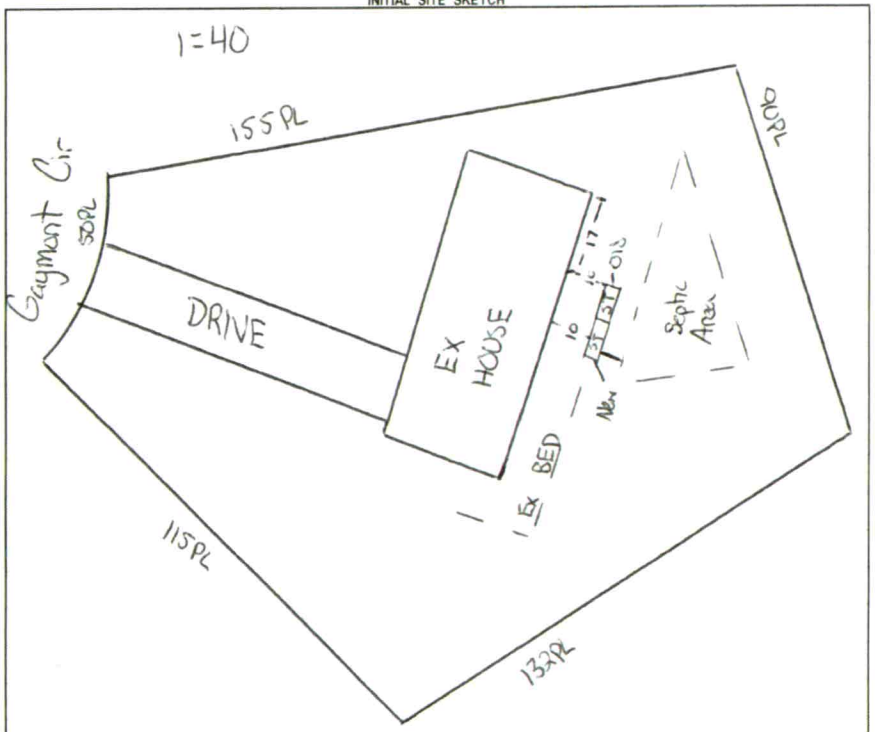

AS BUILT SKETCH

FOR SEPTIC FINAL INSPECTION CALL: 704-664-3703 between 8am-9am the day the inspection is needed. Be sure to speak with an inspector to confirm your time.



Permit can be suspended or revoked if any false information is supplied toward securing the permit / any unauthorized changes are made to the site / any unauthorized changes are made in the installation of the system. **CONTACT A LOCATOR SERVICE PRIOR TO ANY EXCAVATION**

☐ **IMPROVEMENT PERMIT** *with plat valid without expiration.* ☒ **IMPROVEMENT PERMIT** *with site plan valid for 60 mos.* ☒ **AUTHORIZATION TO CONSTRUCT** *valid for period equal to IMPROVEMENT PERMIT--not to exceed 60 mo.*

Owner / Applicant Signature: Date: Installed by: B Rayhill Environmental

IMPROVEMENT PERMIT by: Date: 9/26/22 OPERATION PERMIT by: Date: 10/21/22

AUTHORIZATION TO CONSTRUCT by: Date: 9/26/22 Existing System Inspected by: Date:

FOR SEPTIC FINAL INSPECTION: CALL 704-664-3703 between 8am-9am the day the inspection is needed.