IREDELL COUNTY HEALTH DEPARTMENT

Statesville Phone TR 3-7271 Mooresville Phone No. 664-5281

PERMIT TO INSTALL SEPTIC TANK

Permit No. 47 Permit Date _____ 19__

Owner J. A. Bumgarner Address Rt. 11

Installed By Herman Gibson Address _____


Location of Property Old 115 to Rd 1942. 6th house on right.

Tank		Capacity		Length of Lines		Fixtures	
Block	( )	1000	( )	225'	( )	No. of Baths	( )
Precast	( )	1250	( )	250'	( )	Dishwasher	( )
		1500	( )	Other _____		Garbage Grdr.	( )
		Other _____				Other _____	

NOTIFY HEALTH DEPARTMENT AT LEAST EIGHT HOURS BEFORE TANK IS TO BE INSPECTED.

Final Inspection 6-4-73 Approved (✓) Disapproved ( )

Remarks Repair - tank pumped - 100 gal. Addition

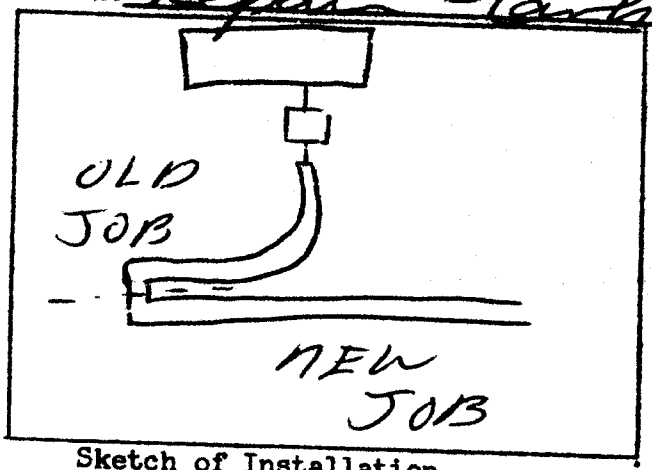

Sketch of Installation

C. S. Hall

Sanitarian