IREDELL COUNTY HEALTH DEPARTMENT

STATESVILLE 704-878-5305 MOORESVILLE 704-664-5281

IMPROVEMENT PERMIT / AUTHORIZATION TO CONSTRUCT / OPERATION PERMIT / EXISTING SYSTEM INSPECTION

PERMIT# REPAIR PIN# 4735-15-0964 DATE 4-4-05

OWNER OR CONTRACTOR SAMUEL MORRISON PHONE: Business Home (704) 873-3617

ADDRESS 1911 OLD WILKESBORO RD. STATESVILLE NC 28625

LOCATION HWY 115 N TO OLD WILKESBORO RD. #1911 ON LEFT PAST BRADLEY FARM RD.

SUBDIVISION BLOCK / SECTION LOT LOT AREA SITE CLASS. PS DESIGN FLOW 360 L.T.A.R. EXISTING

Septic Tank: EXISTING Gallons: STB Date

Pump Tank: Gallons: PT Date

Pump Make: Model Serial No.

Nitrification Field: No Fields 1 Square Feet Linear Feet 150'

No Lines 3 Trench Width 36" Max Trench Bottom Depth 36" Gravel Depth 24"

☐ New System ☐ Repair System Type: I, II, III, IV, V, VI

System Description:

Repair System Description: CONVENTIONAL GRAVITY

Maintenance Agreement Required: ☐ Yes ☑ No

☑ House/Mod. Home No. Bedrooms 3

☐ Mobile Home No. Bathrooms

☐ Business No. Employees

☐ Other


☐ Slab ☐ Crawl Space ☐ Basement w/plumbing ☐ Basement wo/plumbing

Water Supply: ☐ Individual ☐ Public ☑ Community


Comments:/Conditions: ① INSTALL LINES ON CONTOUR ② MAINTAIN SETBACKS ③ SUPPLY LINE MUST CROSS UNDER WATER LINES W/ A MINIMUM 18" SEPARATION ④ SUPPLY LINE MUST BE SLEEVED AND AT MINIMUM 30" BELOW ROAD OR DRIVEWAY

Comments:/Conditions: ⑤ DISCONTINUE USE OF GARDEN IMPACTED ⑥ PUMP OUT TANK & INSTALL FILTER ⑦ THIS SERVES AS A 30-DAY NOV EXPIRING 5-4-05

INITIAL SITE SKETCH

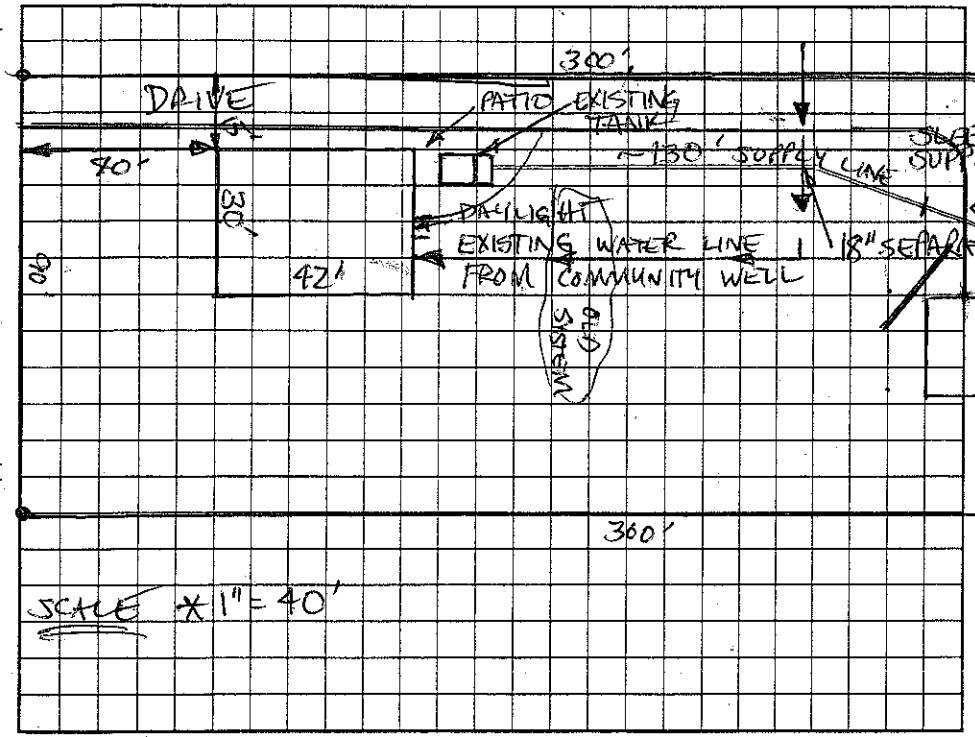

AS BUILT SKETCH

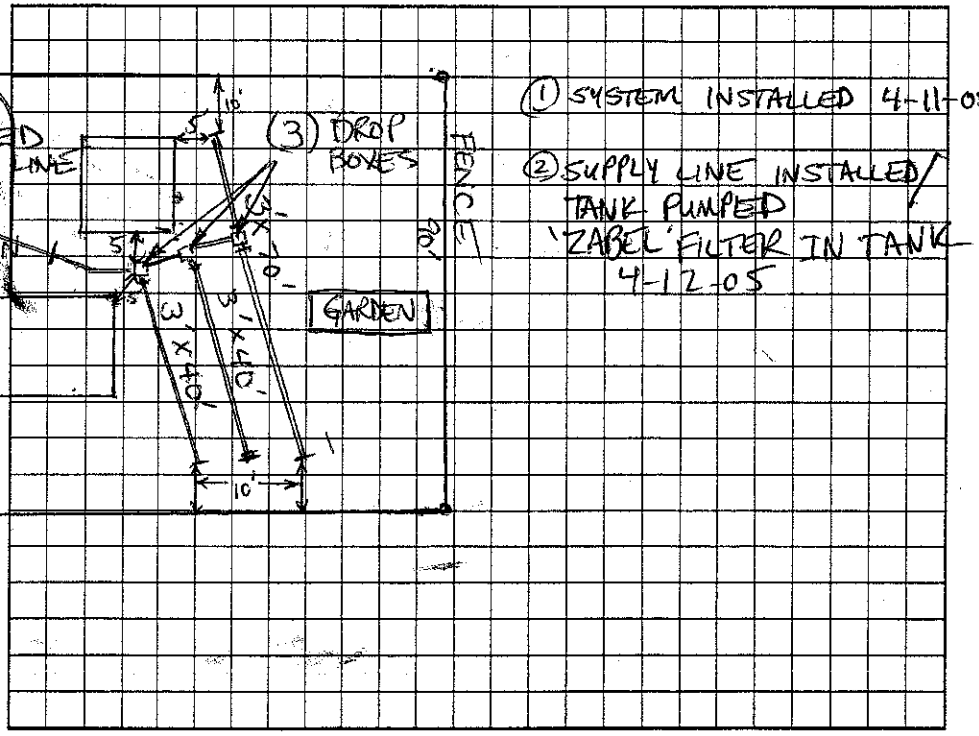

① SYSTEM INSTALLED 4-11-05

② SUPPLY LINE INSTALLED/ TANK PUMPED 'ZABEL' FILTER IN TANK 4-12-05

Permit can be suspended or revoked if any false information is supplied toward securing the permit/any unauthorized changes are made to the site/any unauthorized changes are made in the installation of the system. Improvement Permit with plat valid without expiration. Improvement Permit with site plan valid for sixty months. Authorization to Construct is valid for a period equal to that of Improvement Permit – not to exceed sixty months.

Signed: Samuel C Morrison date

Improvement Permit by: Christopher M. Shevill RS, LSS date 4-4-05

Authorization to Construct by: Christopher M. Shevill RS, LSS date 4-4-05

Installed by: JAMES HUDLER

Operation Permit by: Christopher M. Shevill RS, LSS date 4-12-05

Existing System Inspection by: date

HEALTH DEPT. COPY: WHITE OWNER COPY (FINAL): YELLOW OWNER COPY (INITIAL): PINK