IREDELL COUNTY HEALTH DEPARTMENT

~~Not an Improvement~~ 51571

STATESVILLE 704-878-5305 MOORESVILLE 704-664-5281

IMPROVEMENT PERMIT / CERTIFICATE OF COMPLETION / OPERATION PERMIT / EXISTING SYSTEM INSPECTION

PROPERTY DESCRIPTION NO. CITY DATE 5/23/94 TAX MAP NO. 6K-A-19

OWNER OR CONTRACTOR PENNY HUFFSTICKLER PHONE: Business Home 873-7423 Watershed: ☐ Yes ☑ No

ADDRESS Rt. 3 Box 217 STVL NC 28677

LOCATION NC 115N, TL OLD WILKESBORO RD, TL BRADLEY FARM RD, 1ST MOD. HOME ON (R) PAST STATESVILLE

SUBDIVISION BLOCK / SECTION LOT LOT AREA 1.91 Ac SITE CLASS. RS1 DESIGN FLOW 360 L.T.A.R. 0.35 GPD/FT²

Septic Tank: 1000 Gallons; STB 1012 Date 4/2/94

Pump Tank: Gallons; PT Date

Pump Make: Model Serial No.

Nitrification Field: No Fields 1 Square Feet 1035 Linear Feet ~~375~~ 345

No Lines ~~4~~ 3 Trench Width 36" Max Trench Bottom Depth 18-36" Gravel Depth 12"

☑ New System ☐ Repair System Type: I (II) III, IV, V, VI

System Description: CONV. GRAVITY

Repair System Description: CONV. GRAVITY

Maintenance Agreement Required: ☐ Yes ☑ No

☑ House/Mod. Home No. Bedrooms 3

~~☐ Mobile Home~~ No. Bathrooms 2

☐ Business No. Employees

☐ Other

☐ Slab ☑ Crawl Space ☐ Basement w/plumbing ☐ Basement wo/plumbing


Water Supply: ☐ Individual ☐ Community ☑ Public

WHOLESALE MGMT.


Comments: (1) KEEP SYSTEM MINIMUM 5' FROM MH 10' FROM PROPERTY LINE, 10' FROM WATER LINE (2) INSTALL LINES ON CONTOUR AS FLAGGED, NO DEEPER THAN 36", 9' APART O.C.

Comments: (1) 130' ADDED TO NITRIFICATION LINE DUE TO EQUAL AMOUNT LEFT EXPOSED DURING PERIOD OF SEVERAL HEAVY RAINS (2) KEEP WATER LINE MINIMUM 10' FROM SYSTEM

INITIAL SITE SKETCH

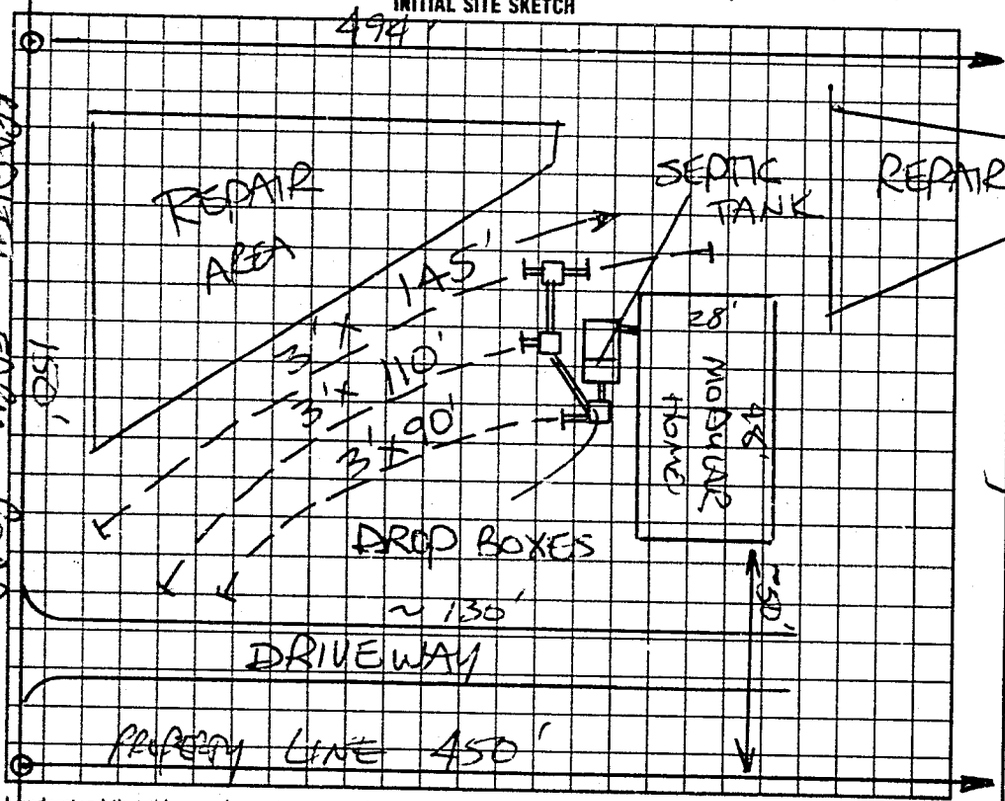

AS BUILT SKETCH

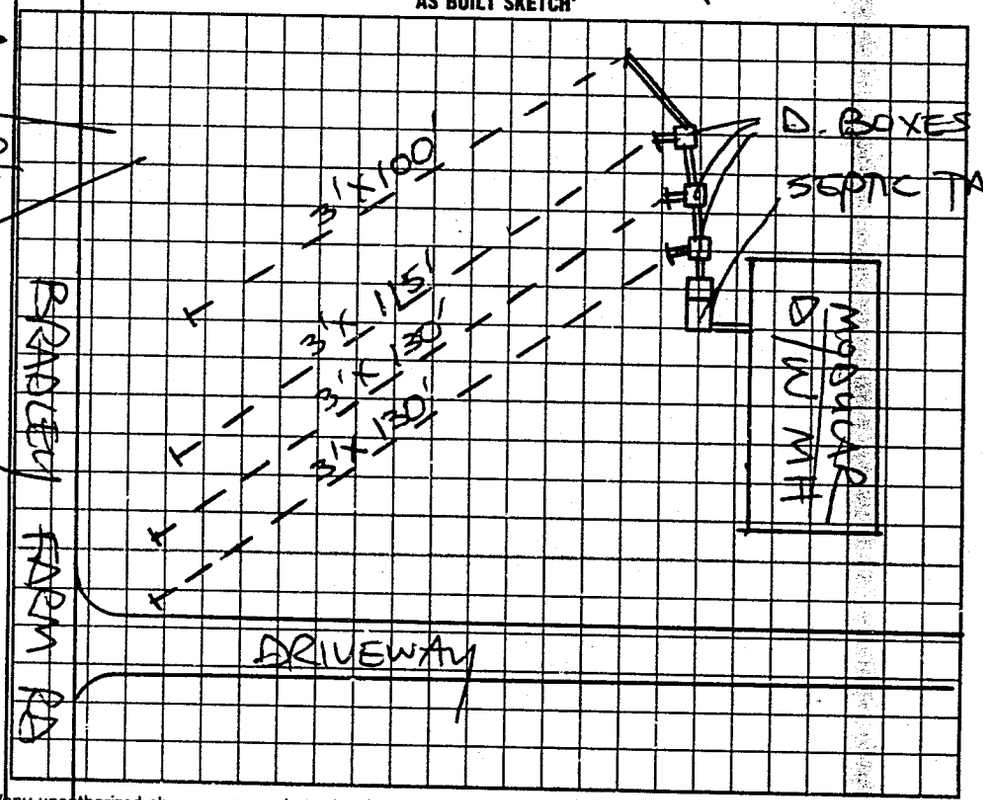

I understand that this permit can be suspended or revoked if any false information is supplied toward securing the permit/any unauthorized changes are made to the site/any unauthorized changes are made in the installation of the system. Improvement Permit is valid for 60 months from date of issuance.

Signed: X Tony Yarn

Improvement Permit by: STEVE HEDRICK date 5/23/94

Existing System Inspection by: date

Installed by: JAMES HUBER / RAY HUFFSTICKLER

Certificate of Completion by: STEVE HEDRICK date 8/1/94

Operation Permit by: date

HEALTH DEPT. COPY: WHITE INSPECTION COPY (FINAL): GREEN OWNER COPY (FINAL): YELLOW INSPECTION COPY (INITIAL): PINK OWNER COPY (INITIAL): GOLD