IREDELL COUNTY HEALTH DEPARTMENT

STATESVILLE 704-878-5305 MOORESVILLE 704-664-5281

IMPROVEMENT PERMIT / AUTHORIZATION TO CONSTRUCT / OPERATION PERMIT / EXISTING SYSTEM INSPECTION

PERMIT# REPAIR PIN# 4735-15-6998 DATE 4-6-04

OWNER OR CONTRACTOR CLIFTON R. TOOTHAKER PHONE: Business 704-682-1273 Home

ADDRESS 1890 OLD WILKESBORO ROAD, STATESVILLE NC 28625-9328

LOCATION NC 115 NORTH, TL OLD WILKESBORO ROAD 'House' on RIGHT AT #1890

SUBDIVISION None BLOCK / SECTION LOT LOT AREA 4.57 ACRES SITE CLASS. PS DESIGN FLOW 480 L.T.A.R. 0.40 GPD/FT² (EXISTING)

Septic Tank: ~~EXISTING~~ Gallons; STB 1007 Date 2-9-04

Pump Tank: Gallons; PT Date

Pump Make: Model Serial No.

Nitrification Field: No Fields 1 Square Feet 1200 Linear Feet 400

No Lines THREE Trench Width 36" Max Trench Bottom Depth 36" Gravel Depth 12"

☐ New System ☑ Repair System Type: I, II, III, IV, V, VI

System Description:

Repair System Description: CONVENTIONAL, GRAVITY

Maintenance Agreement Required: ☐ Yes ☑ No

☑ House/Mod. Home No. Bedrooms 4

☐ Mobile Home No. Bathrooms

☐ Business No. Employees

☐ Other


☐ Slab ☐ Crawl Space ☑ Basement w/plumbing ☐ Basement wo/plumbing

Water Supply: ☐ Individual ☑ Public ☐ Community


Comments:/Conditions: (1) ABANDON OLD DRAINFIELD (2) INSTALL NEW SANITARY TEE IN SEPTIC TANK (3) INSTALL THREE NEW DROP BOXES FEEDING THREE NEW 3'x133' LINES AS SHOWN USING 12" STONE.

Comments:/Conditions: - New Septic Tank installed
- Tuff-Tite filter + ST marker Installed
- Crushed & filled Old Septic Tank

INITIAL SITE SKETCH

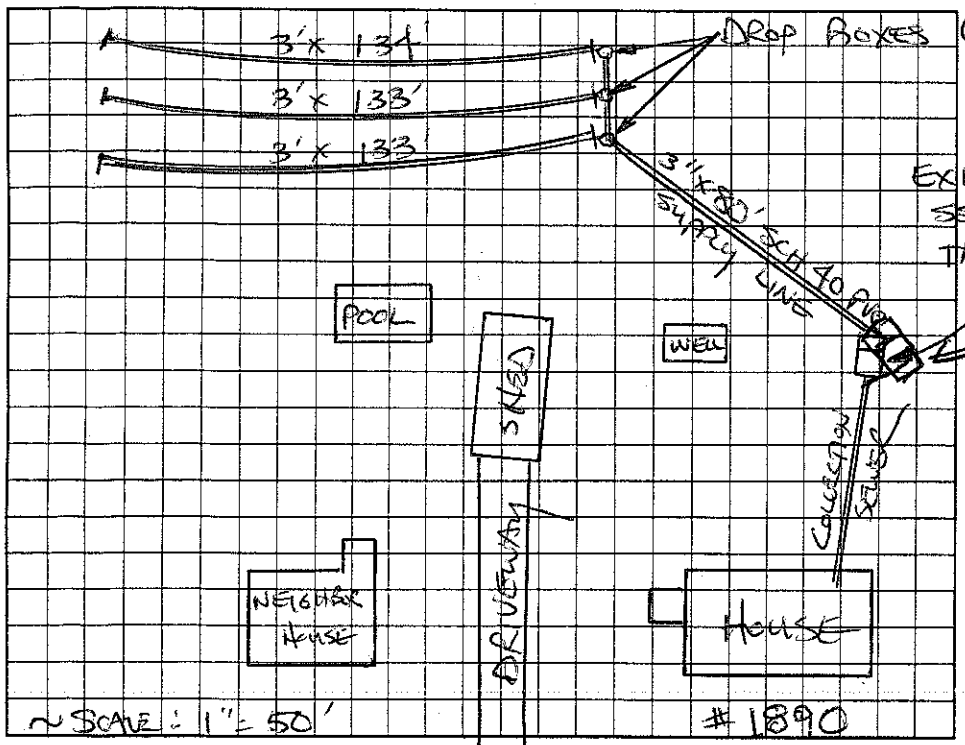

AS BUILT SKETCH

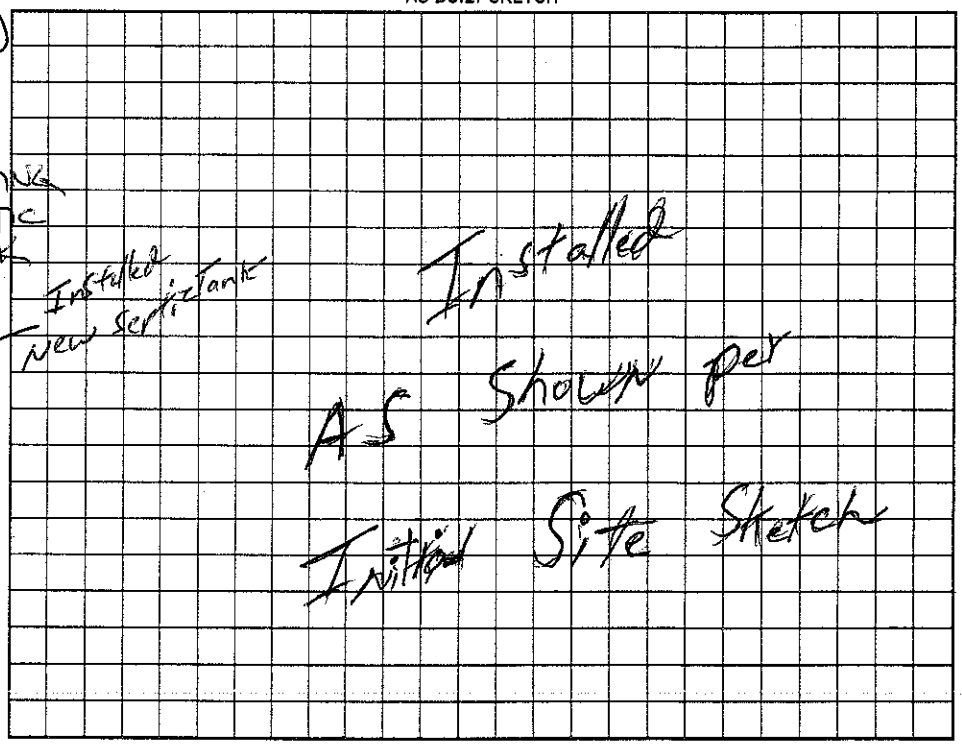

Permit can be suspended or revoked if any false information is supplied toward securing the permit/any unauthorized changes are made to the site/any unauthorized changes are made in the installation of the system. Improvement Permit with plat valid without expiration. Improvement Permit with site plan valid for sixty months. Authorization to Construct is valid for a period equal to that of Improvement Permit – not to exceed sixty months.

Signed: Clifton Toothaker date 4-6-04

Improvement Permit by: STEVE HENDRICK date 4-6-04

Authorization to Construct by: STEVE HENDRICK date 4-6-04

Installed by: James Hudler

Operation Permit by: William O. Johnson date 4/8/04

Existing System Inspection by: date

HEALTH DEPT. COPY: WHITE OWNER COPY (FINAL): YELLOW OWNER COPY (INITIAL): PINK