IREDELL COUNTY HEALTH DEPARTMENT - *ENVIRONMENTAL HEALTH* ☑ STATESVILLE OFFICE 704-878-5305 ☐ MOORESVILLE OFFICE 704-664-5281

IMPROVEMENT PERMIT / AUTHORIZATION TO CONSTRUCT / OPERATION PERMIT / EXISTING SYSTEM INSPECTION

PERMIT # Repair PIN # 4735158602 DATE 8-6-12

OWNER Lucille Johnson APPLICANT: Same PHONE: Home/Cell # 704-450-5327 Business # N/A

SITE ADDRESS 1872 Old Wilkesboro Rd. OWNER / APPLICANT ADDRESS 1872 Old Wilkesboro Rd. Statesville

SITE DIRECTIONS Hwy 115 N Turn Left on Old Wilkesboro, Property on Right

SUBDIVISION N/A BLOCK / SECTION N/A LOT # N/A LOT AREA 0.92 acres DESIGN FLOW 240 gpd L.T.A.R. 0.25

Septic Tank 1000 gal Gallons: STB 1000 Date 6-8-12 ☐ New System ☑ Repair ☐ Expansion System Type I II (III) IV V VI ☑ Residence No. Bedrooms 2 Water Supply

Pump Tank ____ Gallons: P T ____ Date ____ System Description: ☐ Business No. Persons ____ ☐ Private


Pump Make ____ Model ____ Serial # ____ Repair System Description: 25% Reduction ☐ Other No. Employees ____ ☐ Public

No. Nitrification Fields: 1 No. Lines 4 Linear Feet 240' Maintenance Agreement Required ☐ YES ☑ NO ☐ Slab ☑ Crawl Space ☐ Community

Trench Width 36" Max. Trench Bottom Depth 36" Gravel Depth N/A ☑ GRAVITY ☐ PRESSURE ☐ Basement w/plumbing ☐ Basement w/o plumbing

Comments / Conditions: Install 25% Reduction system on contour w/ serial distribution; Replace septic tank if needed. Divert flow of surface water around nitrification field; Install D box to keep existing line in use as well

INITIAL SITE SKETCH

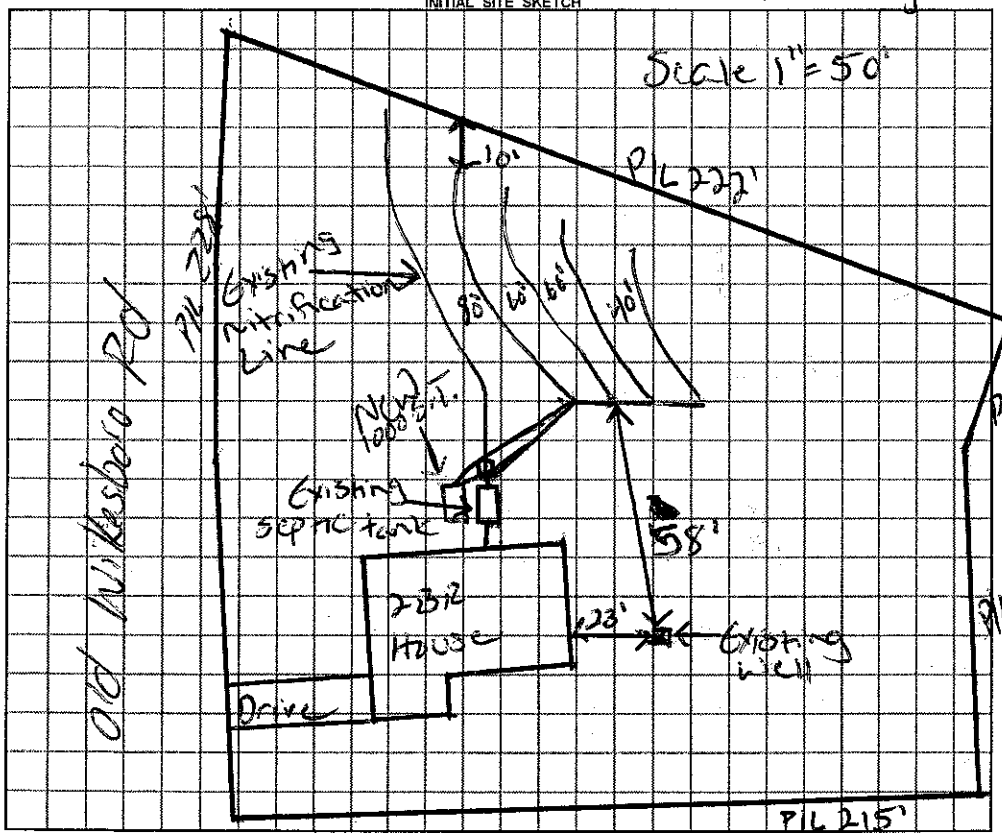

AS BUILT SKETCH

Red Polylock filter installed
2" PVC Tankmaster Infiltrator Quick 4 Installed Top 2 lines 8-8-12 (stopped due to storm)
Bottom Two lines installed as drawn 8-9-12
- System installed as drawn

Permit can be suspended or revoked if any false information is supplied toward securing the permit / any unauthorized changes are made to the site / any unauthorized changes are made in the installation of the system.

☐ ***IMPROVEMENT PERMIT*** with plat valid without expiration. ☑ ***IMPROVEMENT PERMIT*** with plat valid without expiration. site plan valid 60 mo. ☑ ***AUTHORIZATION TO CONSTRUCT*** valid for period equal to IMPROVEMENT PERMIT--not to exceed 60 mo.

Owner / Applicant Signature: Kenneth Johnson Date 8-7-12 Installed by: K & M Grading

IMPROVEMENT PERMIT by: Justin Henderson REHS Date 8-6-12 OPERATION PERMIT by: Justin Henderson REHS Date 8-9-12

AUTHORIZATION TO CONSTRUCT by: Justin Henderson REHS Date 8-6-12 Existing System Inspected by: ____ REHS Date ____

YOU SHOULD CONTACT A LOCATOR SERVICE PRIOR TO ANY EXCAVATION

White Copy – Environmental Health YELLOW COPY (Final) Owner / Applicant PINK COPY (Initial) Owner / Applicant