IREDELL COUNTY HEALTH DEPARTMENT

STATESVILLE 704-878-5305 MOORESVILLE 704-664-5281

3:00 55713

IMPROVEMENT PERMIT / CERTIFICATE OF COMPLETION / OPERATION PERMIT / EXISTING SYSTEM INSPECTION

PROPERTY DESCRIPTION NO. 20901 DATE 4/21/95 TAX MAP NO. 9A-6-A-105

OWNER OR CONTRACTOR JACK HINES PHONE: Business Home 873-5871

ADDRESS 131 DJ DRIVE STATESVILLE, NC 28677 Watershed: ☐ Yes ☒ No

LOCATION NC 115N TL OLD WILKESBORO RD, TR MARSH RD, LOT AT END ON RIGHT

SUBDIVISION NORTHMONT BLOCK / SECTION LOT 105-109 LOT AREA 3.75 AC SITE CLASS. PS DESIGN FLOW 240 L.T.A.R. D-2 600/A-2

Septic Tank: 1000 Gallons; STB 794 Date 5-15-95

Pump Tank: Gallons; PT Date

Pump Make: Model Serial No.

Nitrification Field: No Fields 1 Square Feet 1200 Linear Feet 400

No Lines 3 Trench Width 36" Max Trench Bottom Depth 18 36" Gravel Depth 12"

☑ New System ☐ Repair System Type: I (II) III, IV, V, VI

System Description: CONVENTIONAL GRAVITY

Repair System Description: CONV. GRAVITY W/PUMP

Maintenance Agreement Required: ☐ Yes ☒ No

☑ House/Mod. Home ☐ Mobile Home ☐ Business ☐ Other

No. Bedrooms 2 No. Bathrooms 2 No. Employees


☐ Slab ☑ Crawl Space ☐ Basement w/plumbing ☐ Basement wo/plumbing

Water Supply: ☐ Individual ☐ Community ☑ Public


Comments: ① KEEP SYSTEM MINIMUM 5' FROM HOUSE, 10' FROM WATER LINE ② INSTALL LINES AS FLAGGED ON CONTOUR, NO DEEPER THAN 36", 9' APART MIN. ON CENTER

Comments:

INITIAL SITE SKETCH

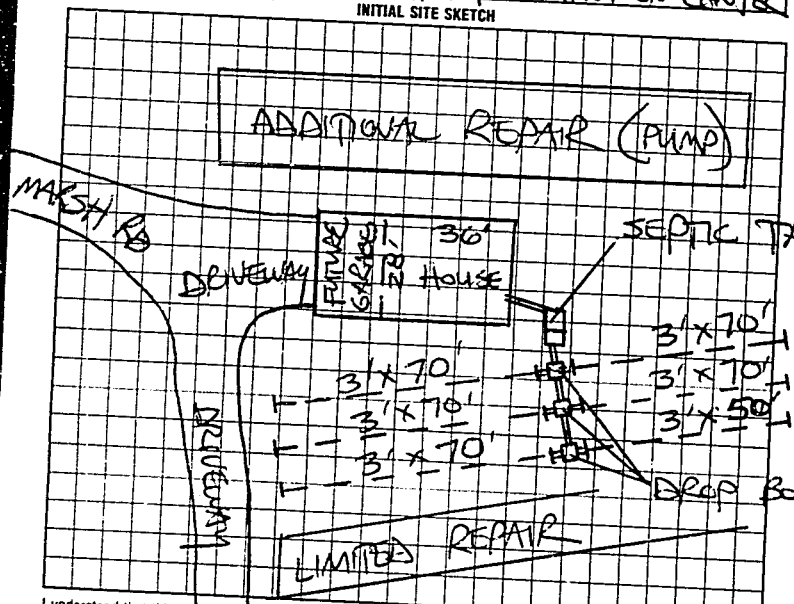

AS BUILT SKETCH

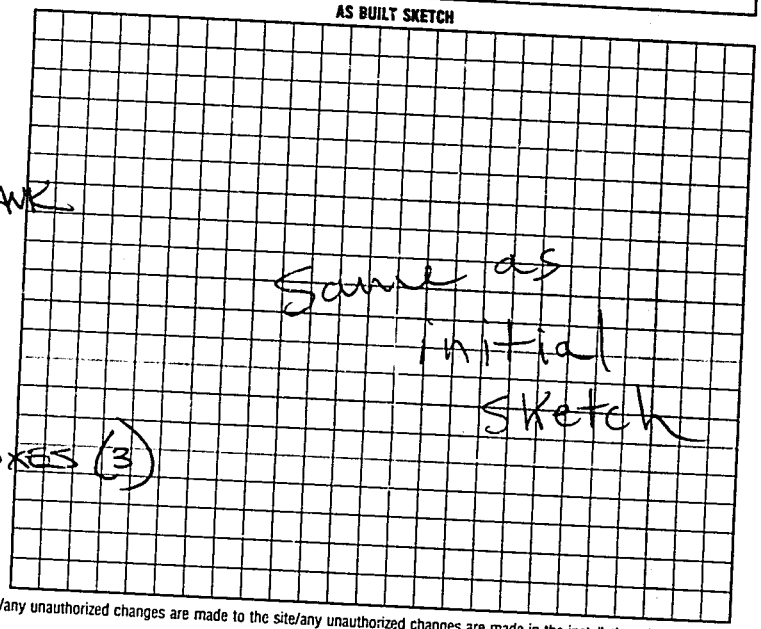

I understand that this permit can be suspended or revoked if any false information is supplied toward securing the permit/any unauthorized changes are made to the site/any unauthorized changes are made in the installation of the system. Improvement Permit is valid for 60 months from date of issuance.

Signed: X Jack L Hines

Improvement Permit by: STEVE HEDRICK date 4/21/95

Existing System Inspection by: date

Installed by: James Hudler

Certificate of Completion by: E.C. Moore date 7-13-95

Operation Permit by date

HEALTH DEPT COPY WHITE INSPECTION COPY (FINAL) GREEN OWNER COPY (FINAL) YELLOW INSPECTION COPY (INITIAL) PINK OWNER COPY (INITIAL) GOLD