IREDELL COUNTY HEALTH DEPARTMENT

Statesville Phone TR 3-7271 Mooresville Phone MO 3-1271

PERMIT TO INSTALL SEPTIC TANK

Permit NO. _____ Permit Date Jan 6 19 64

Owner Mahaffey Builder Address Statesville Rt 2

Installed By " " Address " "


Location of Property Field Stone Drive off Hy 115 North

Tank		Capacity		Length of Lines		Fixtures	
Block	(✓)	800	( )	150'	( )	No. of Baths	(1½)
Precast	( )	900	( )	175'	( )	Dishwasher	( )
		1000	( )	200'	( )	Garbage Grdr.	( )
		1100	(✓)	225'	(✓)	Auto-Washer	(✓)
		1200	( )	250'	( )	Other Sink	
		Other _____		Other _____			

NOTIFY HEALTH DEPARTMENT AT LEAST EIGHT HOURS BEFORE TANK IS TO BE INSPECTED.

Final Inspection 1-8 19 64 Approved (✓) Disapproved ( )

Remarks _____

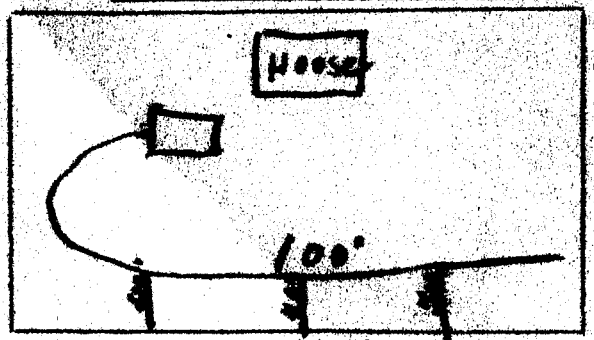

Sketch of Installation

Rel.

Sanitarian