# IREDELL COUNTY HEALTH DEPARTMENT

STATESVILLE 704-878-5305 MOORESVILLE 704-664-5281

## IMPROVEMENT PERMIT / AUTHORIZATION TO CONSTRUCT / OPERATION PERMIT / EXISTING SYSTEM INSPECTION

PERMIT# REPAIR PIN# 4735-19-4843 DATE 7-2-08

OWNER OR APPLICANT ANDREW M. LANIER PHONE: Business 704-876-0746 Home 704-878-6904

ADDRESS 188 FIELDSTONE FARM DRIVE, STATESVILLE NC 28625-2311

LOCATION NC115 N, TL OLD WILKESBORO ROAD TR, FIELDSTONE FARM DRIVE, HOUSE ON RIGHT AT END

SUBDIVISION FIELDSTONE BLOCK / SECTION ____ LOT 18 LOT AREA ~1 ACRE SITE CLASS P3 DESIGN FLOW 360 L.T.A.R. 0.30 GPD/FT²

Septic Tank: 1000 Gallons: STB 1007 Date 4-30-08

Pump Tank: ____ Gallons: PT ____ Date ____

Pump Make: ____ Model EQUIP. Serial No. ____

Nitrification Field: No Fields 1 Square Feet ~520 Linear Feet ~128

No Lines TWO Trench Width 36" Max Trench Bottom Depth 36" Gravel Depth N/A

☐ New System ☑ Repair ☐ Expansion System Type: I II III IV V VI

System Description: ____

Repair System Description: 25% REDUCTION, GRAVITY

Maintenance Agreement Required: ☐ Yes ☑ No

☑ House/Mod. Home No. Bedrooms 3

☐ Mobile Home No. Persons ____

☐ Business No. Employees ____

☐ Other ____


Water Supply: ☑ Individual ☐ Public ☐ Community WELL

☐ Slab ☑ Crawl Space ☐ Basement w/plumbing ☐ Basement wo/plumbing


Comments/Conditions: ① INSTALL NEW SEPTIC TANK AT LOCATION SHOWN. ② INSTALL NEW DROP BOX FEEDING BOTH THE OLD & NEW DRAIN LINES SERIALLY AS SHOWN ③ KEEP SYSTEM MINIMUM 5' FROM P.L.

Comments/Conditions: ST WAS MARKED IN WELL

INITIAL SITE SKETCH ~ SCALE: 1" = 40'

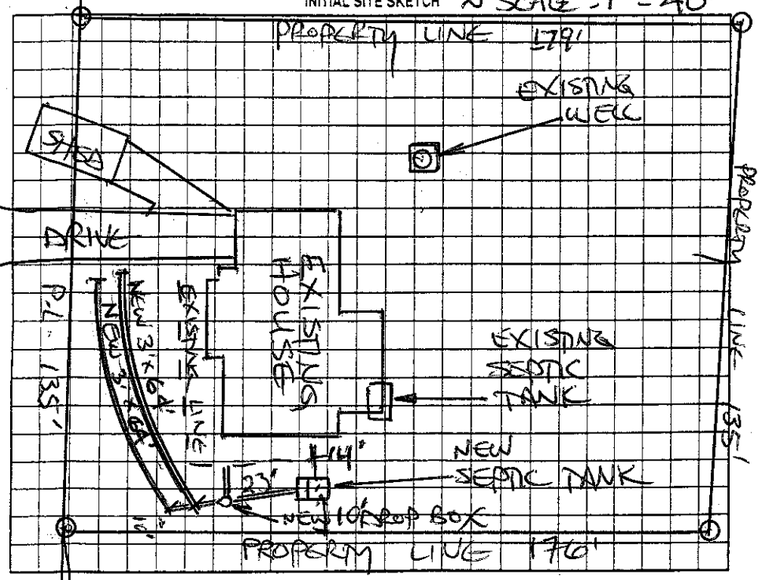


AS BUILT SKETCH

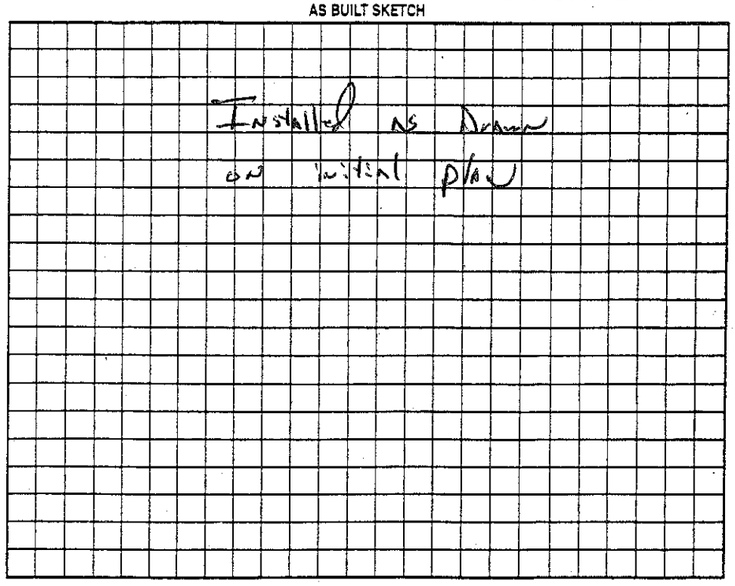


Permit can be suspended or revoked if any false information is supplied toward securing the permit/any unauthorized changes are made to the site/any unauthorized changes are made in the installation of the system. Improvement Permit with plat valid without expiration ☐ Improvement Permit with site plan valid for sixty months ☑ Authorization to Construct is valid for a period equal to that of Improvement Permit – not to exceed sixty months.

Signed Donna S. Lanier date 7-2-08

Improvement Permit by: STEVE HEDRICK date 7-2-08

Authorization to Construct by: STEVE HEDRICK date 7-2-08

Installed by: WAS L. Hun

Operation Permit by: ____, R.S. date 17 July 08

Existing System Inspection by: ____ date ____

HEALTH DEPT. COPY: WHITE OWNER COPY (FINAL): YELLOW OWNER COPY (INITIAL): PINK

FIELDSTONE FARM DRIVE