IREDELL COUNTY HEALTH DEPARTMENT

STATESVILLE 704-878-5305 MOORESVILLE 704-664-5281

2:30 56440

IMPROVEMENT PERMIT / CERTIFICATE OF COMPLETION / OPERATION PERMIT / EXISTING SYSTEM INSPECTION

PROPERTY DESCRIPTION NO. Statesville DATE 6-21-95 TAX MAP NO. 6K-22-A-32 Watershed: ☐ Yes ☑ No

OWNER OR CONTRACTOR E. Douglas madison PHONE: Business 873 0521 Home

ADDRESS 1805 Saphire Rd Statesville

LOCATION 115 N Tb oil wilkesboro Rd TR Canterbury Drive Tb Cartway Lane at end on left

SUBDIVISION Canterbury BLOCK / SECTION LOT 32 LOT AREA .392 acres SITE CLASS. P5 DESIGN FLOW 360 L.T.A.R. .3

Septic Tank: 1000 Gallons; STB 794 Date 5-30-95

Pump Tank: Gallons; PT Date

Pump Make: Model Serial No.

Nitrification Field: No Fields 1 Square Feet 900 Linear Feet 300

No Lines 3 Trench Width 36" Max Trench Bottom Depth 36" Gravel Depth

☐ New System ☐ Repair System Type: I II III IV, V, VI

System Description: Gravity Insiltrator

Repair System Description: Pump To Perus Block Field

Maintenance Agreement Required: ☐ Yes ☑ No

☐ House/Mod. Home No. Bedrooms 3

☐ Mobile Home No. Bathrooms 2

☐ Business No. Employees

☐ Other


☐ Slab ☑ Crawl Space ☐ Basement w/plumbing ☐ Basement wo/plumbing

Water Supply: ☐ Individual ☐ Community ☑ Public


Comments:

Comments:

INITIAL SITE SKETCH

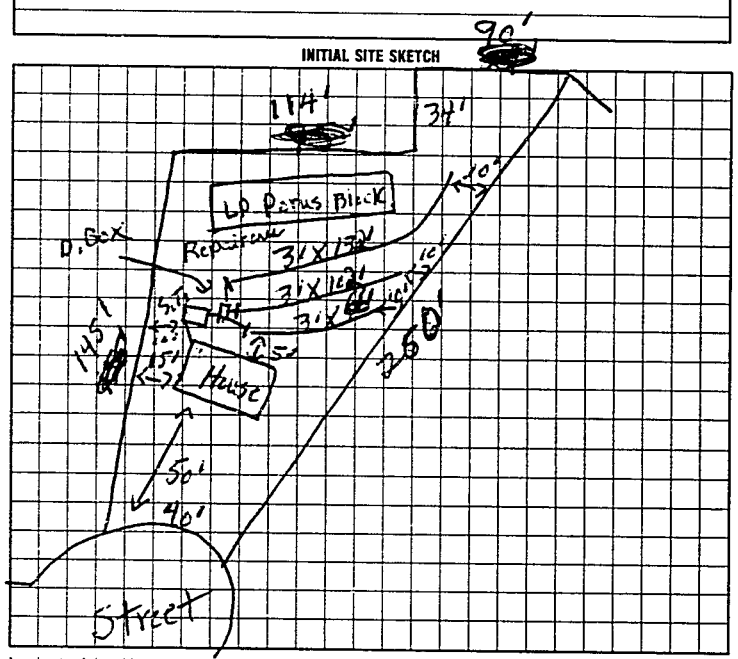

AS BUILT SKETCH

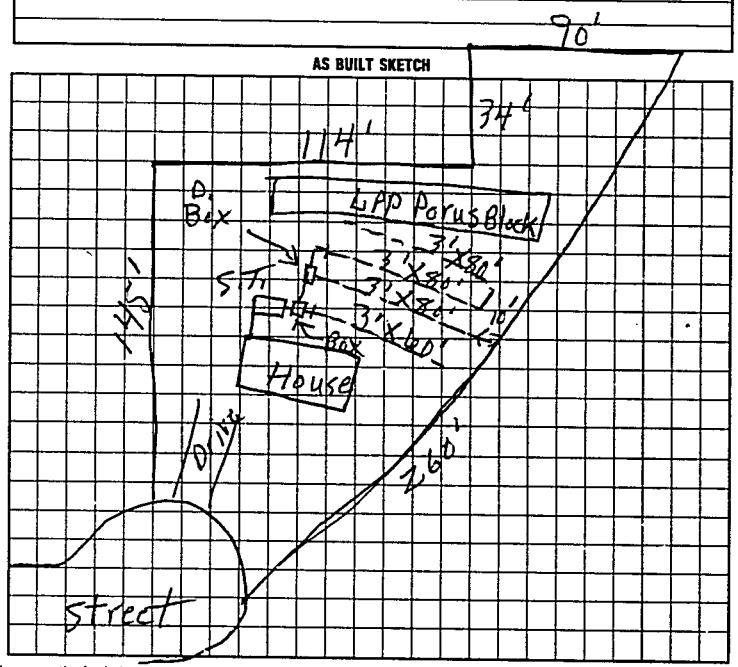

I understand that this permit can be suspended or revoked if any false information is supplied toward securing the permit/any unauthorized changes are made to the site/any unauthorized changes are made in the installation of the system. Improvement Permit is valid for 60 months from date of issuance.

Signed: x Dick Crandell

Improvement Permit by: E.C. moore date 6-21-95

Existing System Inspection by: date

Installed by: A-1 Backhoe

Certificate of Completion by: E.C. moore date 8-15-95

Operation Permit by: date

HEALTH DEPT. COPY: WHITE INSPECTION COPY (FINAL) GREEN OWNER COPY (FINAL) YELLOW INSPECTION COPY (INITIAL) PINK OWNER COPY (INITIAL) GOLD