IREDELL COUNTY HEALTH DEPARTMENT

STATESVILLE 704-878-5305 MOORESVILLE 704-664-5281

IMPROVEMENT PERMIT / AUTHORIZATION TO CONSTRUCT / OPERATION PERMIT / EXISTING SYSTEM INSPECTION

PERMIT# REPAIR PIN# 4735 25 3462 DATE 3-29-01

OWNER OR CONTRACTOR ST. MARK'S BAPTIST CHURCH PHONE: Business Home (704) 878-2281

ADDRESS 1842 OLD WILKESBORO ROAD STATESVILLE, NC 28625

LOCATION NC 115 NORTH, TL OLD WILKESBORO RD, 4TH HOUSE ON RIGHT

SUBDIVISION BLOCK / SECTION LOT LOT AREA LIMITED SITE CLASS PS DESIGN FLOW 360 L.T.A.R. EXISTING

Septic Tank: EXISTING Gallons; STB Date
Pump Tank: Gallons; PT Date
Pump Make: Model Serial No
Nitrification Field: No Fields 1 Square Feet 440 Linear Feet 180
No Lines THREE Trench Width 36" Max Trench Bottom Depth 36" Gravel Depth 12"+

☐ New System ☐ Repair System Type: I (II) III IV V VI
System Description: CONVENTIONAL GRAVITY
Repair System Description: CONV. GRAVITY
Maintenance Agreement Required: ☐ Yes ☑ No

☑ House/Mod. Home No. Bedrooms 3
☐ Mobile Home No. Bathrooms 2
☐ Business No. Employees
☐ Other


☐ Slab ☑ Crawl Space ☐ Basement w/plumbing ☐ Basement wo/plumbing

Water Supply: ☑ Individual ☑ Public ☐ Community


Comments/Conditions: THIS PERMIT SERVES AS NOTICE OF VIOLATION. SYSTEM TO BE REPAIRED WITHIN THIRTY (30) DAYS.

Comments/Conditions:

INITIAL SITE SKETCH

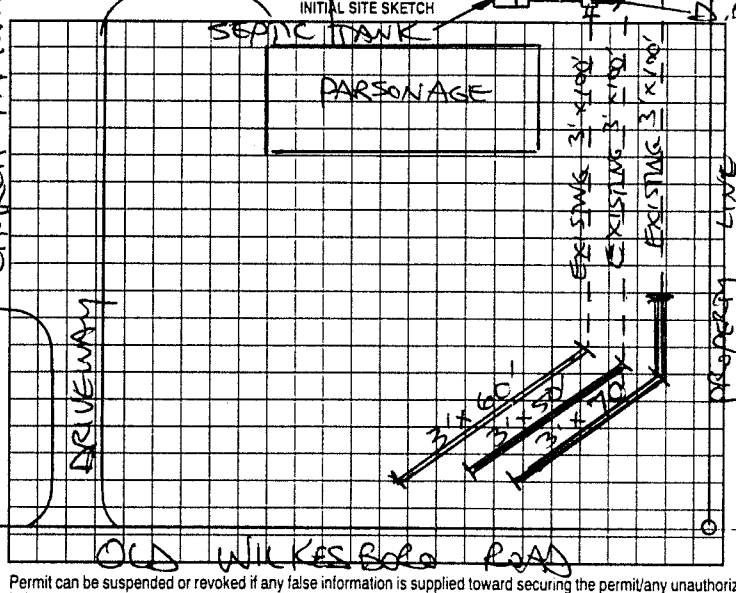

AS BUILT SKETCH

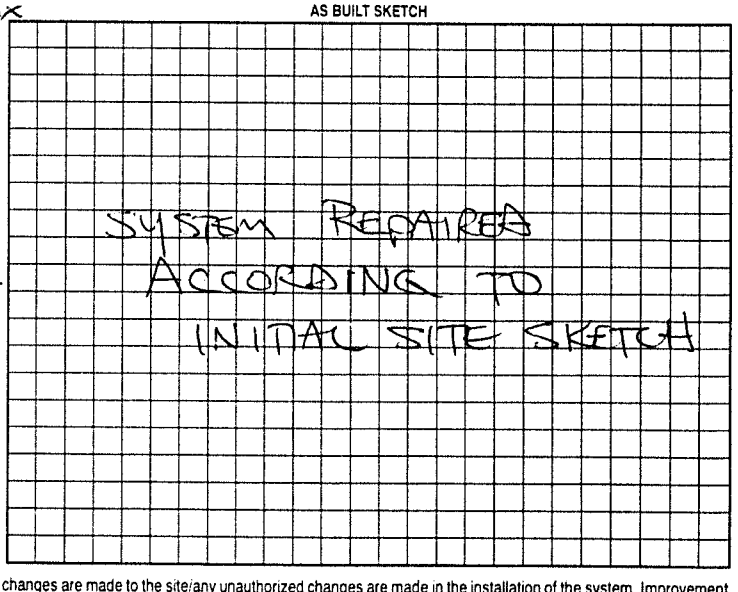

Permit can be suspended or revoked if any false information is supplied toward securing the permit/any unauthorized changes are made to the site/any unauthorized changes are made in the installation of the system. Improvement Permit with plat valid without expiration. Improvement Permit with site plan valid for sixty months. Authorization to Construct is valid for a period equal to that of Improvement Permit – not to exceed sixty months.

Signed: [signature] date 3.29.01

Improvement Permit by: STEVE HEDRICK date 3-29-01

Authorization to Construct by: STEVE HEDRICK date 3-29-01

Installed by: JAMES HUDLER

Operation Permit by: STEVE HEDRICK date 4-6-01

Existing System Inspection by: date

HEALTH DEPT. COPY: WHITE OWNER COPY (FINAL): YELLOW OWNER COPY (INITIAL): PINK