Crandall + O'Brien

IREDELL COUNTY HEALTH DEPARTMENT

STATESVILLE 704-878-5305 MOORESVILLE 704-664-5281

6K-22-A-39 51179

IMPROVEMENT PERMIT / CERTIFICATE OF COMPLETION / OPERATION PERMIT / EXISTING SYSTEM INSPECTION

PROPERTY DESCRIPTION NO. CITY DATE 4/28/94 TAX MAP NO. 6M-A-16-(39) Watershed: ☐ Yes ☑ No

OWNER OR CONTRACTOR C. DOUGLAS MADISON PHONE: Business Home 873-0521

ADDRESS 1805 SAFRIET ROAD, STVL, NC 28677

LOCATION NC 115 N, TL OLD WILKESBORO RD, TR CANDLESTICK DRIVE, 6TH LOT ON (L)

SUBDIVISION CANTERBURY BLOCK / SECTION LOT 39 LOT AREA 88.25' x 170' SITE CLASS. PS DESIGN FLOW 360 L.T.A.R. 0.33 GPD/FT2

Septic Tank: 1000 Gallons; STB 794 Date 5/1/94

Pump Tank: Gallons; PT Date

Pump Make: Model Serial No.

Nitrification Field: No Fields 1 Square Feet 1080 Linear Feet 360

No Lines 5 Trench Width 36" Max Trench Bottom Depth 36" Gravel Depth 12"

☑ New System ☐ Repair System Type: I, II, III, IV, V, VI

System Description: CONVENTIONAL GRAVITY

Repair System Description: CONV. GRAVITY

Maintenance Agreement Required: ☐ Yes ☐ No

☑ House/Mod. Home ☐ Mobile Home ☐ Business ☐ Other

No. Bedrooms 3 No. Bathrooms 2 No. Employees


☐ Slab ☑ Crawl Space ☐ Basement w/plumbing ☐ Basement wo/plumbing

Water Supply: ☐ Individual ☐ Community ☑ Public

Comments:

Comments:

INITIAL SITE SKETCH

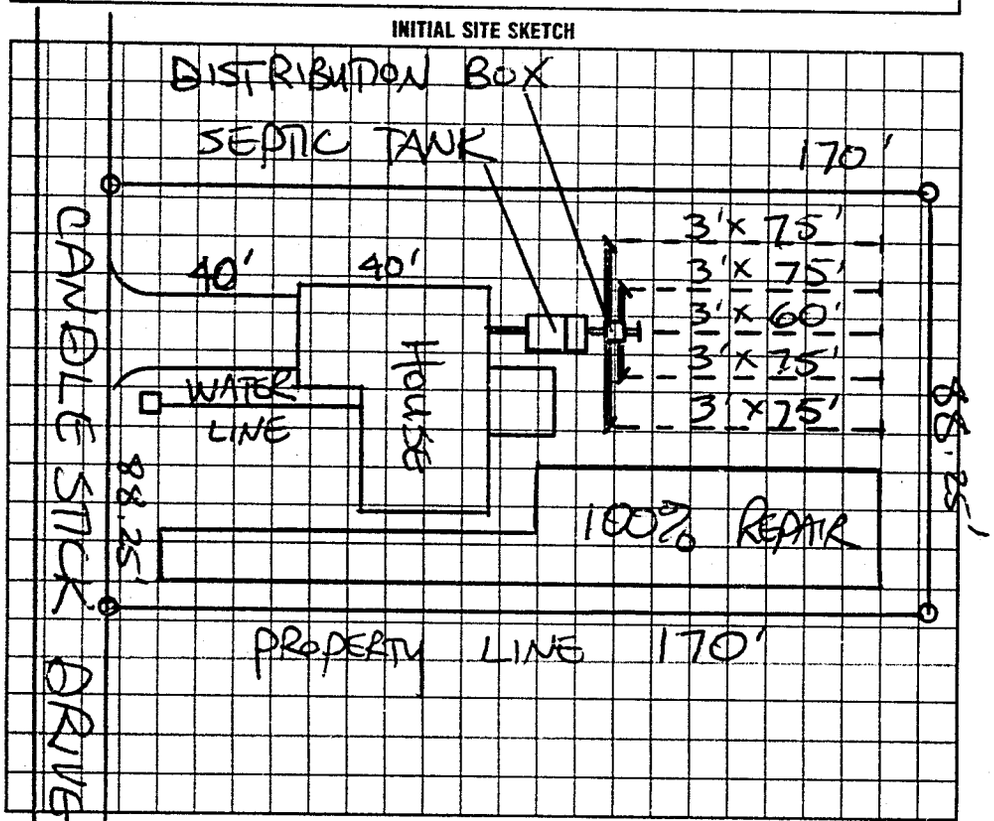

AS BUILT SKETCH

SYSTEM INSTALLED ACCORDING TO INITIAL SITE SKETCH

I understand that this permit can be suspended or revoked if any false information is supplied toward securing the permit/any unauthorized changes are made to the site/any unauthorized changes are made in the installation of the system. Improvement Permit is valid for 60 months from date of issuance.

Signed: !

Improvement Permit by: STEVE HEDRICK date 4/28/94

Existing System Inspection by: date

Installed by: A-1 BACKHOE

Certificate of Completion by: STEVE HEDRICK date 7/6/94

Operation Permit by: date

HEALTH DEPT COPY WHITE INSPECTION COPY (FINAL) GREEN OWNER COPY (FINAL) YELLOW INSPECTION COPY (INITIAL) PINK OWNER COPY (INITIAL) GOLD

8 6 7 1 0 0