IREDELL COUNTY HEALTH DEPARTMENT

STATESVILLE 704-878-5305 MOORESVILLE 704-664-5281

52509

IMPROVEMENT PERMIT / CERTIFICATE OF COMPLETION / OPERATION PERMIT / EXISTING SYSTEM INSPECTION

PROPERTY DESCRIPTION NO. CITY DATE 8/9/94 TAX MAP NO. 6M-A-16 (PART) Watershed: ☐ Yes ☒ No

OWNER OR CONTRACTOR C. D. MADISON PHONE: Business 873-0521 Home

ADDRESS 1805 SAFRIET ROAD, STATESVILLE, NC 28677

LOCATION NC 115 N TO OLD WILKESBORO ROAD, AT NE INTERSECTION OF CANDLESTICK DRIVE.

SUBDIVISION CANTERBURY BLOCK / SECTION LOT 44 LOT AREA 115'x130' SITE CLASS. PS DESIGN FLOW 360 L.T.A.R. 0.30 GPD/FT2

Septic Tank: 1000 Gallons; STB 794 Date 6/27/94

Pump Tank: Gallons; PT Date

Pump Make: Model Serial No.

Nitrification Field: No Fields 1 Square Feet 1200 Linear Feet 400

No Lines 6 Trench Width 36" Max Trench Bottom Depth 18-36 Gravel Depth 12"

☒ New System ☐ Repair System Type: I, II, III, IV, V, VI

System Description: CONVENTIONAL GRAVITY

Repair System Description: PPBPS GRAVITY

Maintenance Agreement Required: ☐ Yes ☒ No

☒ House/Mod. Home No. Bedrooms 3

☐ Mobile Home No. Bathrooms 2

☐ Business No. Employees

☐ Other


☐ Slab ☒ Crawl Space ☐ Basement w/plumbing ☐ Basement wo/plumbing

Water Supply: ☐ Individual ☐ Community ☒ Public

Comments: SYSTEM MUST BE INSTALLED PRECISELY AS SHOWN AND FLAGGED ON SITE.

Comments:

INITIAL SITE SKETCH

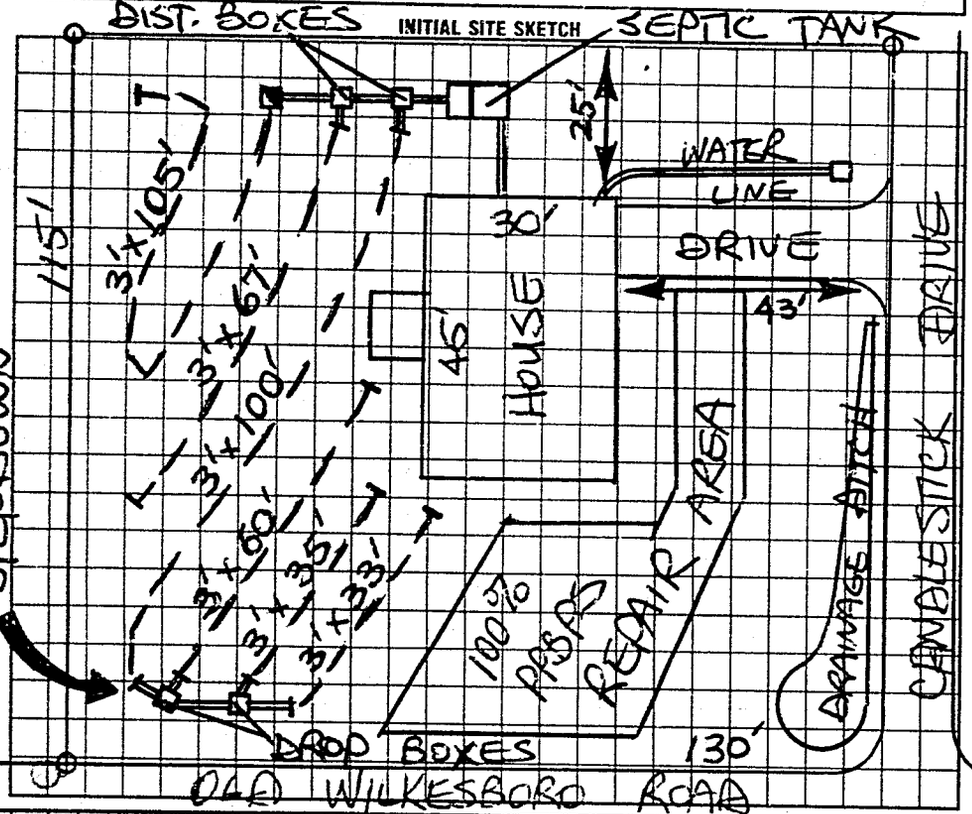

AS BUILT SKETCH

SYSTEM INSTALLED ACCORDING TO INITIAL SITE SKETCH

I understand that this permit can be suspended or revoked if any false information is supplied toward securing the permit/any unauthorized changes are made to the site/any unauthorized changes are made in the installation of the system. Improvement Permit is valid for 60 months from date of issuance.

Signed:

Improvement Permit by: STEVE HEDRICK date 8/9/94

Existing System Inspection by: date

Installed by: A-1 BACK HOE

Certificate of Completion by: STEVE HEDRICK date 10/7/94

Operation Permit by: date

HEALTH DEPT. COPY: WHITE INSPECTION COPY (FINAL): GREEN OWNER COPY (FINAL): YELLOW INSPECTION COPY (INITIAL): PINK OWNER COPY (INITIAL): GOLD