IREDELL COUNTY HEALTH DEPARTMENT

6K-22-A-42

52527

STATESVILLE 704-878-5305 MOORESVILLE 704-664-5281

IMPROVEMENT PERMIT / CERTIFICATE OF COMPLETION / OPERATION PERMIT / EXISTING SYSTEM INSPECTION

PROPERTY DESCRIPTION NO. CITY DATE 8/4/94 TAX MAP NO. 6M-A-16 (PART)

OWNER OR CONTRACTOR C.D. MADISON PHONE: Business 873-0521 Home Watershed: ☐ Yes ☐ No

ADDRESS 1805 SAFRIET ROAD STATESVILLE NC 28677

LOCATION NC 115 N, TL OLD WILKESBORO RD, TR CANDLESTICK DR, 3RD LOT ON (L)

SUBDIVISION CANTERBURY BLOCK / SECTION LOT 42 LOT AREA 75X202.87X248 SITE CLASS. PS DESIGN FLOW 360 L.T.A.R. 0.30 GPD/FT2

Septic Tank: 1000 Gallons; STB 19A Date 6/28/94

Pump Tank: Gallons; PT Date

Pump Make: Model Serial No.

Nitrification Field: No Fields 1 Square Feet 1200 Linear Feet 400

No Lines 5 Trench Width 36" Max Trench Bottom Depth 18-36" Gravel Depth 12"

☑ New System ☐ Repair System Type: I (II) III, IV, V, VI

System Description: CONVENTIONAL GRAVITY

Repair System Description: CONVENTIONAL PUMP

Maintenance Agreement Required: ☐ Yes ☑ No

☑ House/Mod. Home ☐ Mobile Home ☐ Business ☐ Other

No. Bedrooms 3 No. Bathrooms 2 No. Employees


☐ Slab ☑ Crawl Space ☐ Basement w/plumbing ☐ Basement wo/plumbing

Water Supply: ☐ Individual ☐ Community ☑ Public


Comments: ① KEEP SYSTEM MINIMUM 5' FROM HOUSE, 10' FROM PROPERTY LINE ② INSTALL TANK & LINES AS SHALLOW AS POSSIBLE AS SHOWN

Comments:

INITIAL SITE SKETCH

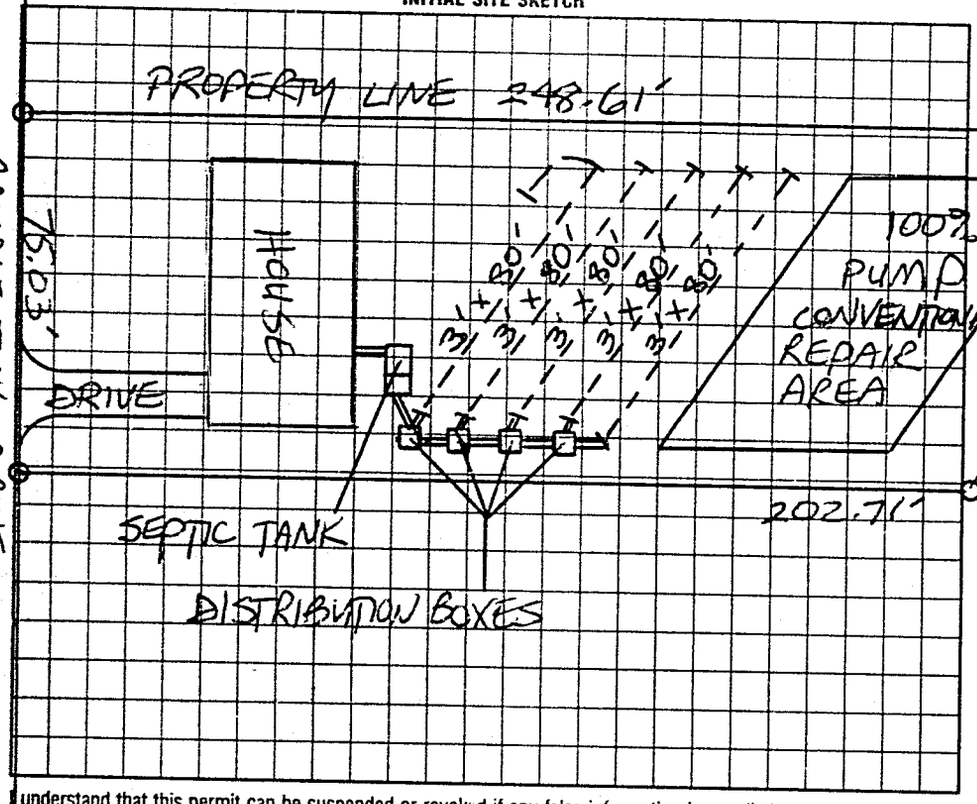

AS BUILT SKETCH

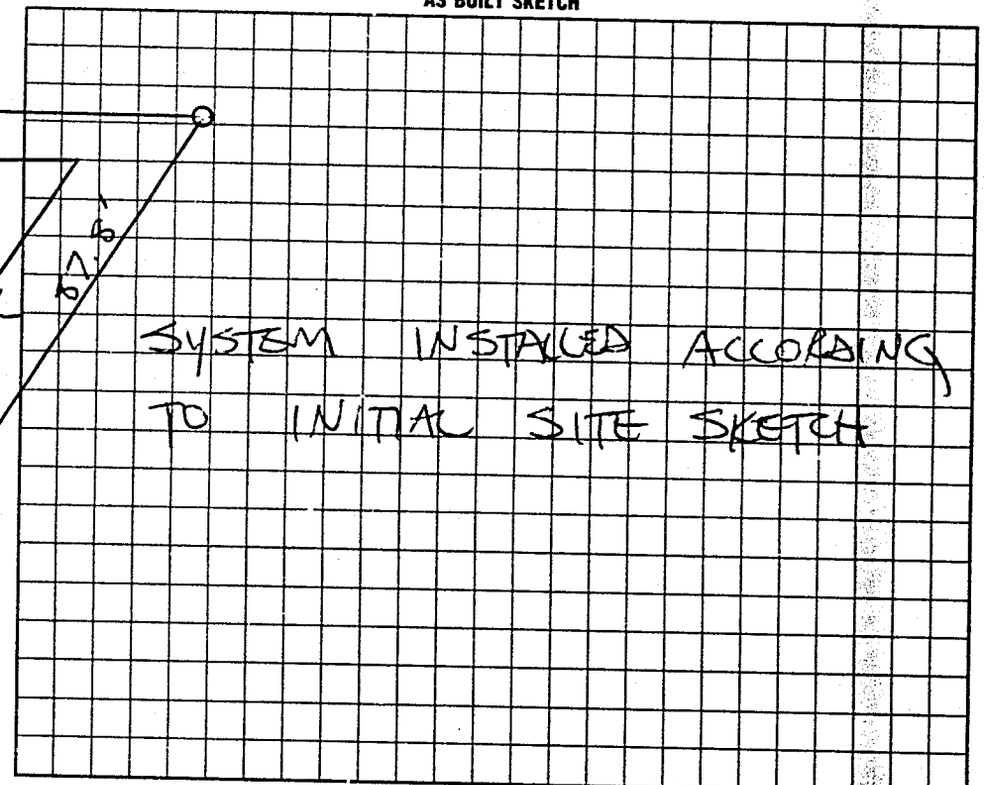

I understand that this permit can be suspended or revoked if any false information is supplied toward securing the permit/any unauthorized changes are made to the site/any unauthorized changes are made in the installation of the system. Improvement Permit is valid for 60 months from date of issuance.

Signed: T Richard Broadwell

Improvement Permit by: STEVE HEDRICK date 8/4/94

Existing System Inspection by: date

Installed by: A-1 BACKHOE

Certificate of Completion by: STEVE HEDRICK date 10/6/94

Operation Permit by: date

HEALTH DEPT. COPY: WHITE INSPECTION COPY (FINAL): GREEN OWNER COPY (FINAL): YELLOW INSPECTION COPY (INITIAL): PINK OWNER COPY (INITIAL): GOLD