IREDELL COUNTY HEALTH DEPARTMENT

STATESVILLE 704-878-5305 MOORESVILLE 704-664-5281

IMPROVEMENT PERMIT / CERTIFICATE OF COMPLETION / OPERATION PERMIT / EXISTING SYSTEM INSPECTION

~~52569~~

PROPERTY DESCRIPTION NO. CITY DATE 6/1/94 TAX MAP NO. 6M-A-16 (PART) Watershed: ☐ Yes ☑ No

OWNER OR CONTRACTOR C. D. MADISON PHONE: Business Home 873-0521

ADDRESS 1805 SAFRIET RD STVL, NC, 28677

LOCATION NC 115 N, TL OLD WILKESBORO RD, TR CANDLESTICK DR, 10th LOT ON (R)

SUBDIVISION CANTERBURY BLOCK / SECTION LOT 10 LOT AREA 100'X 150 SITE CLASS. PS' DESIGN FLOW 360 L.T.A.R. 0.33 GPD/FT2

Septic Tank: 1000 Gallons; STB 794 Date 6/2/94

Pump Tank: Gallons; PT Date

Pump Make: Model Serial No.

Nitrification Field: No Fields 1 Square Feet 1080 Linear Feet 360

No Lines 6 Trench Width 36" Max Trench Bottom Depth 18-36 Gravel Depth 12"

☑ New System ☐ Repair System Type: I (II) III, IV, V, VI

System Description: CONVENTIONAL GRAVITY

Repair System Description: PPBPS REPAIR

Maintenance Agreement Required: ☐ Yes ☑ No

☐ Slab ☑ Crawl Space ☐ Basement w/plumbing ☐ Basement wo/plumbing

☑ House/Mod. Home No. Bedrooms 3

☐ Mobile Home No. Bathrooms 2

☐ Business No. Employees


☐ Other

Water Supply:
☐ Individual
☐ Community
☑ Public

Comments:

Comments:

INITIAL SITE SKETCH

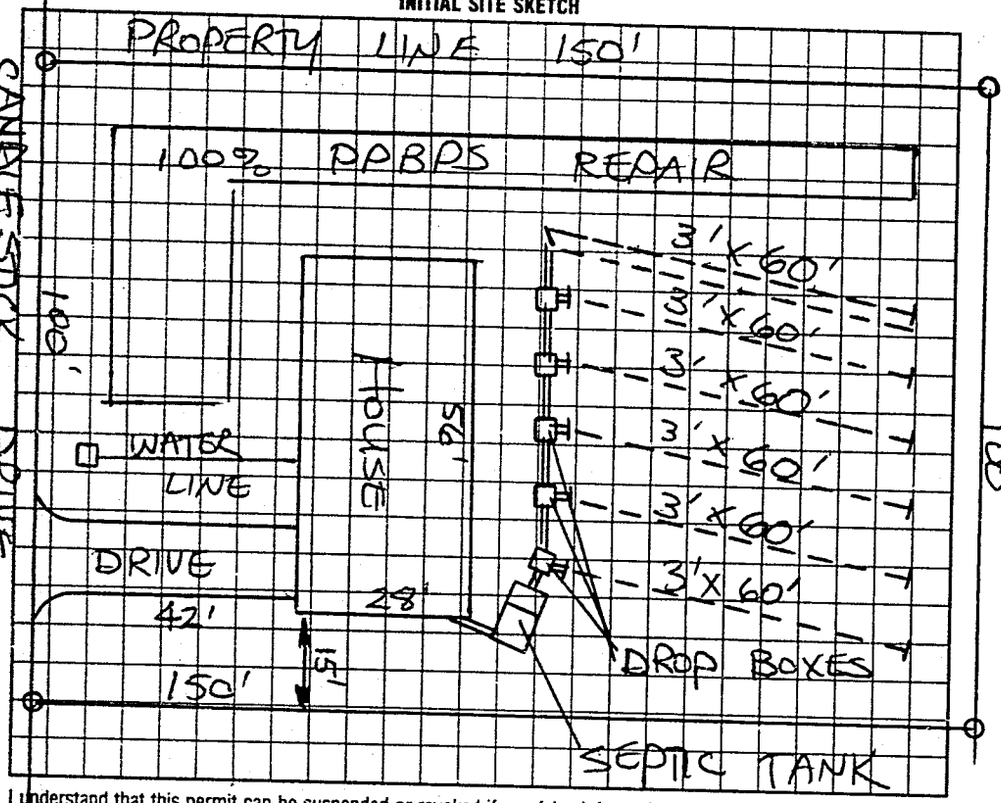

AS BUILT SKETCH

SYSTEM INSTALLED ACCORDING TO INITIAL SITE SKETCH

I understand that this permit can be suspended or revoked if any false information is supplied toward securing the permit/any unauthorized changes are made to the site/any unauthorized changes are made in the installation of the system. Improvement Permit is valid for 60 months from date of issuance.

Signed: Dick Crandall

Improvement Permit by: STEVE HEDRICK date 6/1/94

Existing System Inspection by: date

Installed by: A-1 BACKHOE

Certificate of Completion by: STEVE HEDRICK date 9/16/94

Operation Permit by: date

HEALTH DEPT. COPY: WHITE INSPECTION COPY (FINAL): GREEN OWNER COPY (FINAL): YELLOW INSPECTION COPY (INITIAL): PINK OWNER COPY (INITIAL): GOLD