IREDELL COUNTY HEALTH DEPARTMENT

STATESVILLE 704-878-5305 MOORESVILLE 704-664-5281

50564

IMPROVEMENT PERMIT / CERTIFICATE OF COMPLETION / OPERATION PERMIT / EXISTING SYSTEM INSPECTION

PROPERTY DESCRIPTION NO. CITY DATE 3/11/99 TAX MAP NO. 6M-A-16 (41) PART OF Watershed: ☐ Yes ☒ No

OWNER OR CONTRACTOR C.D. MADISON PHONE: Business ~~Home~~ 873-0521

ADDRESS 1805 SAFRIET ROAD STATESVILLE NC 28677

LOCATION NC115N TL OLD WILKSBORO HIGHWAY, TR CANAVESTICK DRIVE, 4TH LOT ON LEFT

SUBDIVISION CANTERBURY BLOCK / SECTION LOT 41 LOT AREA LIMITED SITE CLASS. PS DESIGN FLOW 360 L.T.A.R. 0.30 GPD

Septic Tank: 1000 Gallons; STB 794 Date 2/1/94

Pump Tank: Gallons; PT Date

Pump Make: Model Serial No.

Nitrification Field: No Fields 1 Square Feet 1200 Linear Feet 400

No Lines 7 Trench Width 36" Max Trench Bottom Depth 18-36" Gravel Depth 12"

☒ New System ☐ Repair System Type: I, II, III, IV, V, VI

System Description: CONVENTIONAL GRAVITY

Repair System Description: PPBPS

Maintenance Agreement Required: ☐ Yes ☒ No

☒ House/Mod. Home ☐ Mobile Home ☐ Business ☐ Other

No. Bedrooms 3 No. Bathrooms 2 No. Employees


☐ Slab ☒ Crawl Space ☐ Basement w/plumbing ☐ Basement wo/plumbing

Water Supply: ☐ Individual ☐ Community ☒ Public

Comments: SYSTEM MUST BE INSTALLED EXACTLY ACCORDING TO INITAL SITE SKETCH — NO MARGIN ALLOWED FOR ERROR!

Comments:

INITIAL SITE SKETCH

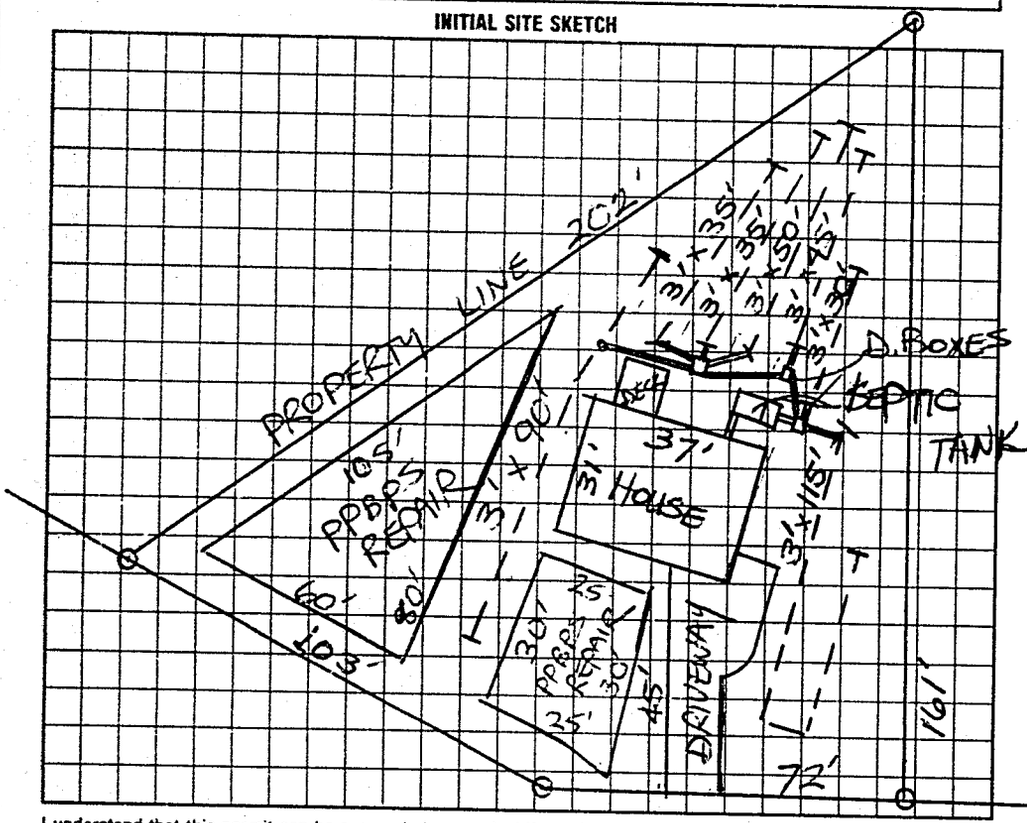

AS BUILT SKETCH

SYSTEM INSTALLED ACCORDING TO INITAL SITE SKETCH

I understand that this permit can be suspended or revoked if any false information is supplied toward securing the permit/any unauthorized changes are made to the site/any unauthorized changes are made in the installation of the system. Improvement Permit is valid for 60 months from date of issuance.

Signed: Richard Campbell

Improvement Permit by: STEVE HEDRICK date 3/11/99

Existing System Inspection by: date

Installed by: A-1 BACK HOE

Certificate of Completion by: STEVE HEDRICK date 5/6/99

Operation Permit by: date

HEALTH DEPT. COPY: WHITE INSPECTION COPY (FINAL): GREEN OWNER COPY (FINAL): YELLOW INSFECTION COPY (INITIAL): PINK OWNER COPY (INITIAL): GOLD