Crandall + O'Brien — Not on Computer — 6K-22-A-7 — 51180

IREDELL COUNTY HEALTH DEPARTMENT

STATESVILLE 704-878-5305 MOORESVILLE 704-664-5281

IMPROVEMENT PERMIT / CERTIFICATE OF COMPLETION / OPERATION PERMIT / EXISTING SYSTEM INSPECTION

PROPERTY DESCRIPTION NO. CITY DATE 5/4/94 TAX MAP NO. 6M-A-16 (7) Watershed: ☐ Yes ☒ No

OWNER OR CONTRACTOR C. D. MADISON PHONE: Business 873-0521 Home

ADDRESS 1805 SAFRIET RD, STVL NC 28677

LOCATION NC115 N TL OLD WILKESBORO RD, TR CANDLESTICK DR, 7TH LOT ON (R)

SUBDIVISION CANTERBURY BLOCK / SECTION LOT 7 LOT AREA ~100X150' SITE CLASS PS DESIGN FLOW 360 L.T.A.R.

Septic Tank: 1000 Gallons; STB 794 Date 4-27-94
Pump Tank: Gallons; PT Date
Pump Make: Model Serial No.
Nitrification Field: No Fields 1 Square Feet 1035 Linear Feet 345
No Lines Trench Width 36" Max Trench Bottom Depth 18-36" Gravel Depth 12"

☒ New System ☐ Repair System Type: I, II, III, IV, V, VI
System Description: CONVENTIONAL GRAVITY
Repair System Description: PPBPS PUMP.
Maintenance Agreement Required: ☐ Yes ☒ No

☒ House/Mod. Home No. Bedrooms 3
☐ Mobile Home No. Bathrooms 2
☐ Business No. Employees
☐ Other


☐ Slab ☒ Crawl Space ☐ Basement w/plumbing ☐ Basement wo/plumbing

Water Supply: ☐ Individual ☐ Community ☒ Public


Comments (1) KEEP SYSTEM MINIMUM 5' FROM HOUSE, 10' FROM PROPERTY LINE, 10' FROM WATER LINE. (2) INSTALL LINES ON CONTOUR, NO DEEPER THAN 36", 9' APART ON CENTER

Comments: System could not be installed as permitted due to gulley. Partial repair Area below system. Remainder of repair area in front yard, PPBPS for both. Route all surface water and gutter drains around septic system.

INITIAL SITE SKETCH

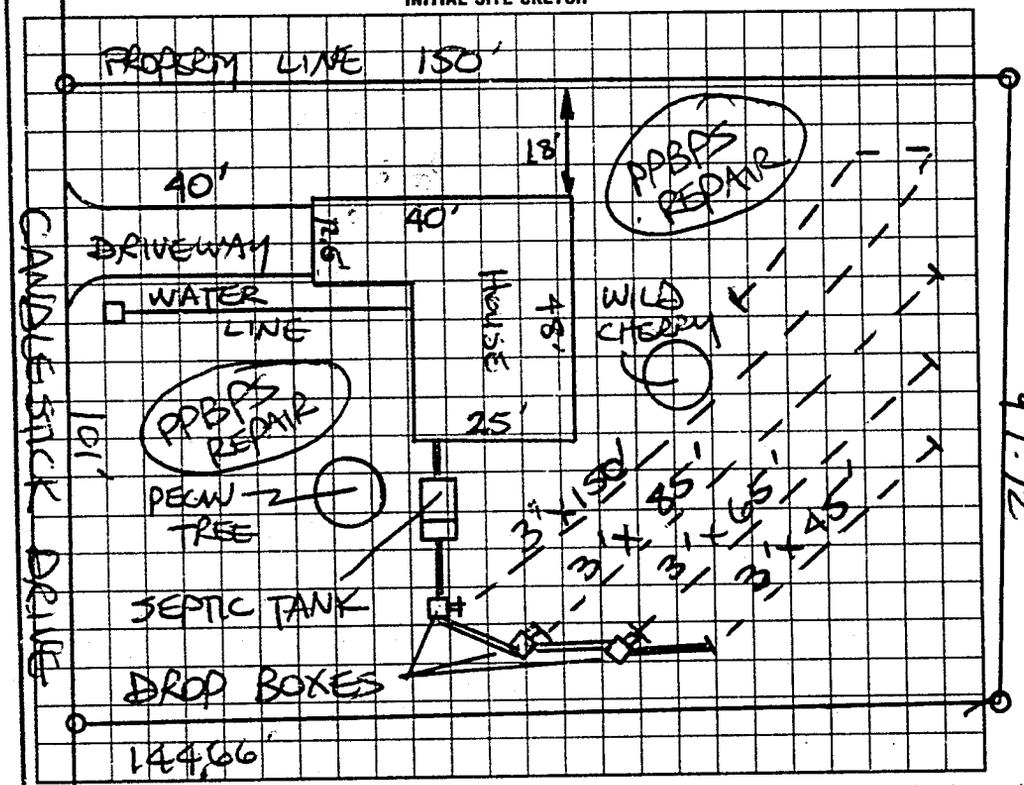

AS BUILT SKETCH

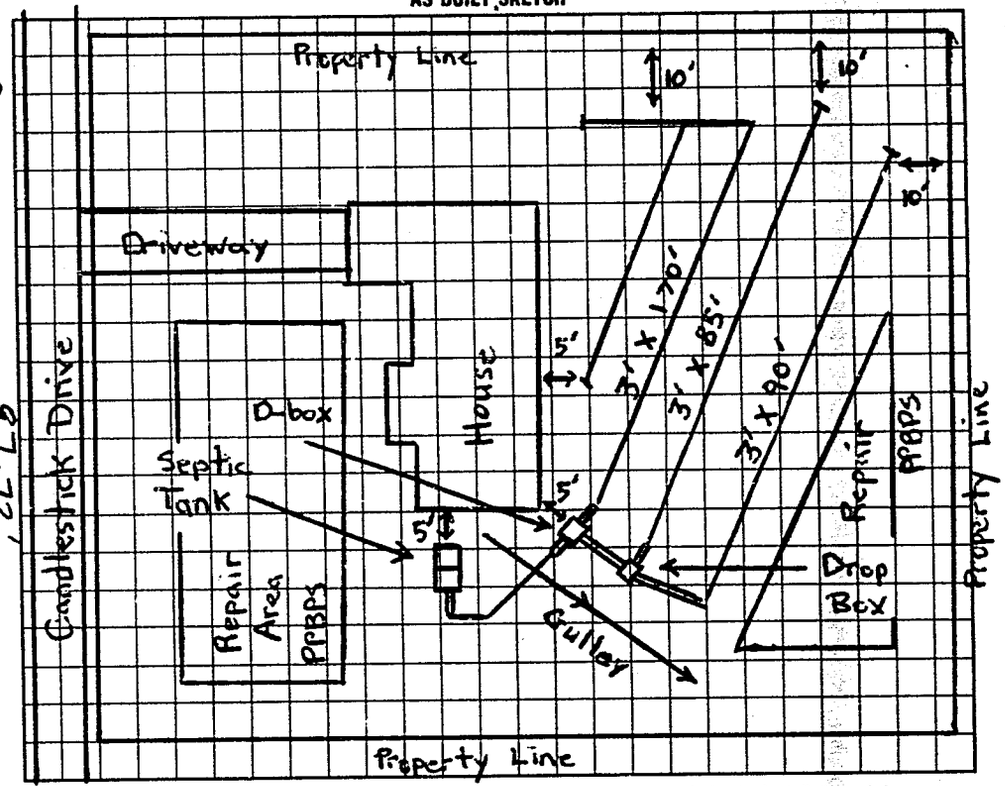

I understand that this permit can be suspended or revoked if any false information is supplied toward securing the permit/any unauthorized changes are made to the site/any unauthorized changes are made in the installation of the system. Improvement Permit is valid for 60 months from date of issuance.

Signed: X

Improvement Permit by: STEVE HEDRICK date 5/4/94

Existing System Inspection by: date

Installed by: A-1 Backhoe

Certificate of Completion by: Michael J. Dennard date 7-11-94

Operation Permit by: date

HEALTH DEPT. COPY: WHITE INSPECTION COPY (FINAL): GREEN OWNER COPY (FINAL): YELLOW INSPECTION COPY (INITIAL): PINK OWNER COPY (INITIAL): GOLD

5210