Not on Terminal GK-23-21

IREDELL COUNTY HEALTH DEPARTMENT

STATESVILLE 704-878-5305 MOORESVILLE 704-664-5281

IMPROVEMENT PERMIT / CERTIFICATE OF COMPLETION / OPERATION PERMIT / EXISTING SYSTEM INSPECTION

PROPERTY DESCRIPTION NO. CITY DATE 4/12/94 TAX MAP NO. 6M-A-16 (8) Watershed: ☐ Yes ☑ No

OWNER OR CONTRACTOR C. D. MADISON PHONE: Business Home 873-0521

ADDRESS 1807 SAFRIET DR. STVL, NC 28677

LOCATION NC 115 N, TL OLD WILKESBORO RD, TR CANDLESTICK DR, 8th LOT ON (R)

SUBDIVISION CANTERBURY BLOCK / SECTION LOT 8 LOT AREA 100'x150' SITE CLASS. PS DESIGN FLOW L.T.A.R. 0.33 GPD/FT²

Septic Tank: 1000 Gallons; STB 794 Date 4/94

Pump Tank: Gallons; PT Date

Pump Make: Model Serial No.

Nitrification Field: No Fields 1 Square Feet 1080 Linear Feet 360

No Lines 4 Trench Width 36" Max Trench Bottom Depth 18-36" Gravel Depth 12"

☑ New System ☐ Repair System Type: I, (II), III, IV, V, VI

System Description: CONV. GRAVITY

Repair System Description: PPBPS

Maintenance Agreement Required: ☐ Yes ☑ No

☑ House/Mod. Home No. Bedrooms 3

☐ Mobile Home No. Bathrooms 2

☐ Business No. Employees

☐ Other


☐ Slab ☑ Crawl Space ☐ Basement w/plumbing ☐ Basement wo/plumbing

Water Supply: ☐ Individual ☐ Community ☑ Public

Comments: (1) KEEP SYSTEM MINIMUM 5' FROM HOUSE, 10' FROM PROPERTY LINE (2) INSTALL LINES ON CONTOUR, NO DEEPER THAN 36" 4' APART ON CENTERS (3) USE DROP BOXES FOR SERIAL DISTRIBUTION

Comments:

INITIAL SITE SKETCH

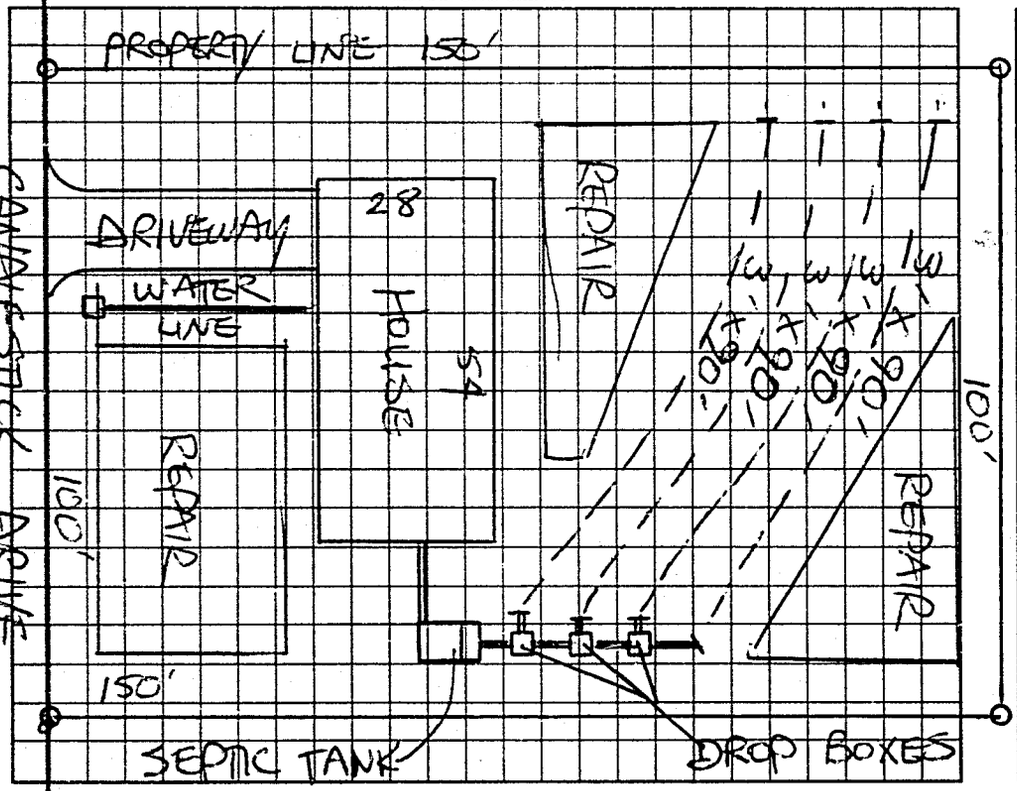

AS BUILT SKETCH

SYSTEM INSTALLED ACCORDING TO INITAL SITE SKETCH

I understand that this permit can be suspended or revoked if any false information is supplied toward securing the permit/any unauthorized changes are made to the site/any unauthorized changes are made in the installation of the system. Improvement Permit is valid for 60 months from date of issuance.

Signed:

Improvement Permit by: STEVE HEDRICK date 4/12/94

Existing System Inspection by: date

Installed by: A-1 BACKHOE

Certificate of Completion by: STEVE HEDRICK date 7/6/94

Operation Permit by: date

HEALTH DEPT. COPY: WHITE INSPECTION COPY (FINAL): GREEN OWNER COPY (FINAL): YELLOW INSPECTION COPY (INITIAL): PINK OWNER COPY (INITIAL): GOLD