Crandall + O'Brien

IREDELL COUNTY HEALTH DEPARTMENT

STATESVILLE 704-878-5305 MOORESVILLE 704-664-5281

~~Tutor Completion~~ 6K-22-A-9 50900

IMPROVEMENT PERMIT / CERTIFICATE OF COMPLETION / OPERATION PERMIT / EXISTING SYSTEM INSPECTION

PROPERTY DESCRIPTION NO. CITY DATE 4/12/94 TAX MAP NO. 6M-A-16 (9) Watershed: ☐ Yes ☒ No

OWNER OR CONTRACTOR C. D. MADISON PHONE: Business 873-0521 Home

ADDRESS 1805 SAFRIET DRIVE, STVL, NC 28677

LOCATION NC 115 N TL OLD WILKESBORO RD, TR CANDLESTICK DR 9th LOT ON (R)

SUBDIVISION CANTERBURY BLOCK / SECTION LOT 9 LOT AREA 100' x 150' SITE CLASS. PS DESIGN FLOW 360 L.T.A.R. 0.35 GAD/FT2

Septic Tank: 1000 Gallons; STB 794 Date 4/21/94

Pump Tank: Gallons; PT Date

Pump Make: Model Serial No.

Nitrification Field: No Fields 1 Square Feet 1035 Linear Feet 345

No Lines 5 Trench Width 36 Max Trench Bottom Depth 18-36" Gravel Depth 12"

☒ New System ☐ Repair System Type: I, (II), III, IV, V, VI

System Description: CONV, GRAVITY

Repair System Description: PARTIAL PPBPS // CONV.

Maintenance Agreement Required: ☐ Yes ☒ No

☒ House/Mod. Home No. Bedrooms 3

☐ Mobile Home No. Bathrooms 2

☐ Business No. Employees

☐ Other


☐ Slab ☒ Crawl Space ☐ Basement w/plumbing ☐ Basement wo/plumbing

Water Supply: ☐ Individual ☐ Community ☒ Public

Comments: (1) KEEP SYSTEM MINIMUM 5' FROM HOUSE, 10' FROM PROPERTY LINE (2) INSTALL LINES ON CONTOUR, NO DEEPER THAN 36" 9' APART ON CENTER (3) USE DROP BOX DISTRIBUTION (SERIAL)

Comments:

INITIAL SITE SKETCH

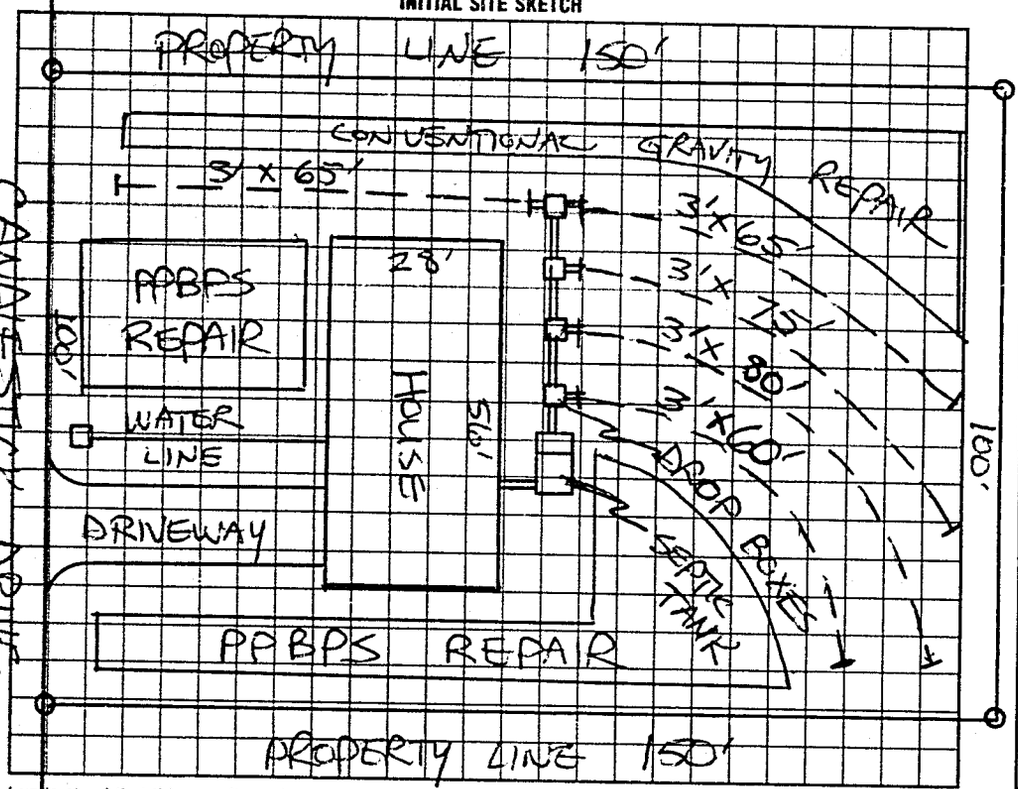

AS BUILT SKETCH

SYSTEM INSTALLED ACCORDING TO INITIAL SITE SKETCH

I understand that this permit can be suspended or revoked if any false information is supplied toward securing the permit/any unauthorized changes are made to the site/any unauthorized changes are made in the installation of the system. Improvement Permit is valid for 60 months from date of issuance.

Signed:

Improvement Permit by: STEVE HEDRICK date 4/12/94

Existing System Inspection by: date

Installed by: A-1 BACKHOE

Certificate of Completion by: STEVE HEDRICK date 5/26/94

Operation Permit by: date

HEALTH DEPT. COPY: WHITE INSPECTION COPY (FINAL): GREEN OWNER COPY (FINAL): YELLOW INSPECTION COPY (INITIAL): PINK OWNER COPY (INITIAL): GOLD