IREDELL COUNTY HEALTH DEPARTMENT

STATESVILLE 704-878-5305 MOORESVILLE 704-664-5281

IMPROVEMENT PERMIT / CERTIFICATE OF COMPLETION / OPERATION PERMIT / EXISTING SYSTEM INSPECTION

PROPERTY DESCRIPTION NO. CITY DATE 4-4-96 TAX MAP NO. 6M-A-16 (PART) Watershed: ☐ Yes ☒ No

OWNER OR CONTRACTOR C.D. MADISON JR. PHONE: Business 873-0521 Home 871-1536

ADDRESS 1805 SARIET ROAD, STATESVILLE NC 28677

LOCATION NC 115 N TL OLD WILKESBORO RD, TR CANDLESTICK, 6TH LOT ON RIGHT

SUBDIVISION CANTERBURY BLOCK / SECTION LOT 6 LOT AREA 0.3807 AC SITE CLASS PS DESIGN FLOW 360 L.T.A.R. 0.33 GPD/FT²

Septic Tank: 1000 Gallons; STB 794 Date 5-15-96

Pump Tank: Gallons; PT Date

Pump Make: Model Serial No.

Nitrification Field: No Fields 1 Square Feet 1080 Linear Feet 360

No Lines 4 Trench Width 36" Max Trench Bottom Depth 18-36" Gravel Depth 12"

☒ New System ☐ Repair System Type: I, II, III, IV, V, VI

System Description: CONVENTIONAL GRAVITY

Repair System Description: PPBPS, PUMP

Maintenance Agreement Required: ☐ Yes ☒ No

☐ House/Mod. Home ☐ Mobile Home ☐ Business ☐ Other

No. Bedrooms 3 No. Bathrooms 2 No. Employees


☐ Slab ☒ Crawl Space ☐ Basement w/plumbing ☐ Basement wo/plumbing

Water Supply: ☒ Individual ☐ Community ☒ Public


Comments: ① USE THREE FLOW DIVIDER TEES TO ACHIEVE EQUAL DISTRIBUTION INTO EACH OF FOUR 90' LINES, ② KEEP SYSTEM MINIMUM 5' FROM HOUSE, 10 FROM PROPERTY LINE, 10 FROM WATER LINE

Comments:

INITIAL SITE SKETCH

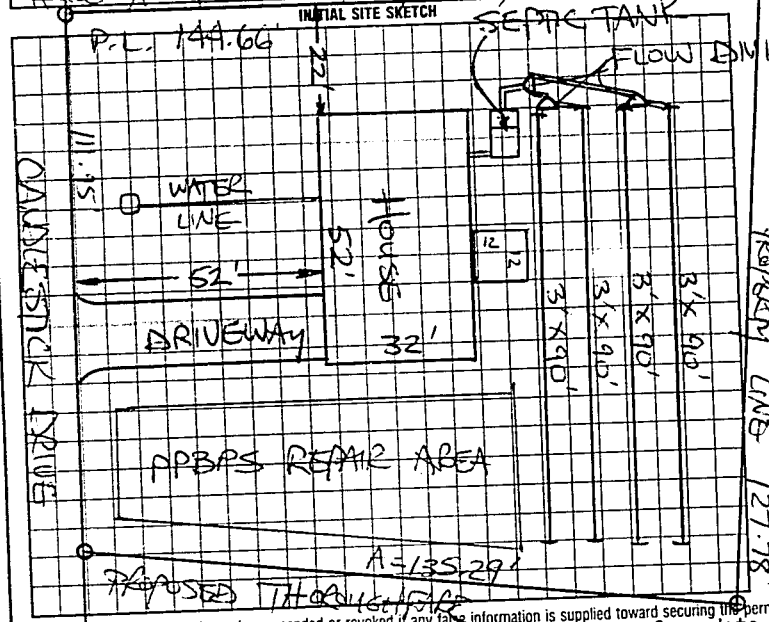

AS BUILT SKETCH

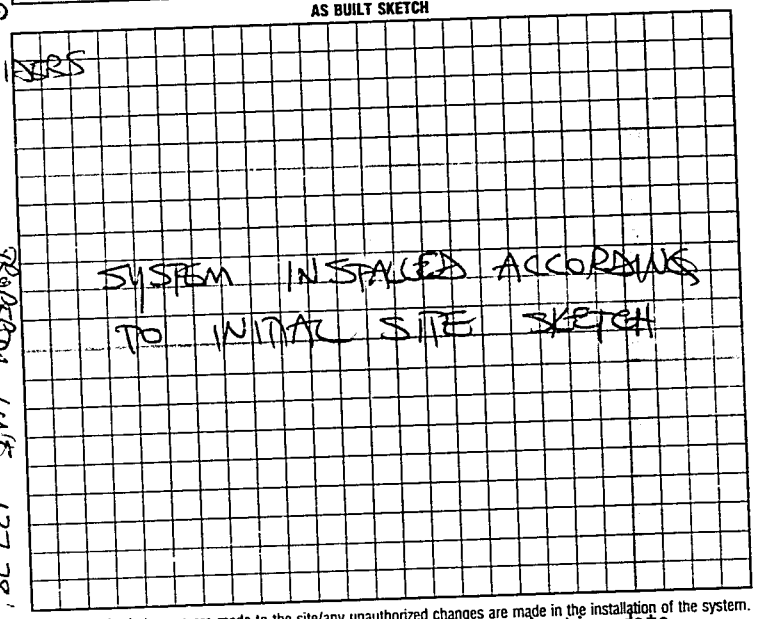

I understand that this permit can be suspended or revoked if any false information is supplied toward securing the permit/any unauthorized changes are made to the site/any unauthorized changes are made in the installation of the system. Authorization to Construct is valid five (5) years from date of issuance. Improvement Permit has no expiration date.

Signed: STEVE HENDRICK date 4-4-96

Improvement Permit by STEVE HENDRICK date 4-4-96

Installed by: A-1 BACKHOE date

Certificate of Completion by: STEVE HENDRICK date 6-20-96

Operation Permit by

AUTHORIZATION TO CONSTRUCT: HEALTH DEPT. COPY: WHITE | INSPECTION COPY (FINAL) GREEN | OWNER COPY (FINAL) YELLOW | INSPECTION COPY (INITIAL) PINK | OWNER COPY (INITIAL) GOLD

992100