2/27/95 Paid #50

THIS PERMIT VOIDS PREVIOUS ISSUED 10/24/95 FOR LOT #21 & 22

IREDELL COUNTY HEALTH DEPARTMENT

STATESVILLE 704-878-5305 MOORESVILLE 704-664-5281

IMPROVEMENT PERMIT / CERTIFICATE OF COMPLETION / OPERATION PERMIT / EXISTING SYSTEM INSPECTION

PROPERTY DESCRIPTION NO. CITY DATE 2-26-96 TAX MAP NO 6K-22-A-21 Watershed: ☐ Yes ☑ No

OWNER OR CONTRACTOR C. DOUGLAS MADISON PHONE Business 871-1536 Home 873-0521

ADDRESS 1805 SAFRIET ROAD, STATESVILLE NC 28677

LOCATION NC 115N, TL OLD WILKESBORO RD, TR CANDLESTICK DR, TL CHALICE COURT, AT END

SUBDIVISION CANTERBURY BLOCK / SECTION II LOT 21 LOT AREA 0.4561 AC SITE CLASS PS DESIGN FLOW 360 LTAR 0.30 GPD/FT2

Septic Tank: 1000 Gallons; STB 794 Date 3-9-96
Pump Tank: ____ Gallons; PT ____ Date ____
Pump Make: ____ Model EQUIVALENT Serial No ____
Nitrification Field: No Fields 1 Square Feet 1200 Linear Feet 300+
No Lines 4 Trench Width 36" Max Trench Bottom Depth 24-36" Gravel Depth N/A

☑ New System ☐ Repair System Type: I II ☒ III IV V
System Description CHAMBERED GRAVITY
Repair System Description: ~~CHAMBERED~~ PUMP/GRAVITY
Maintenance Agreement Required: ☐ Yes ☑ No

☑ House/Mod Home No. Bedrooms 3
☐ Mobile Home No. Bathrooms 2
☐ Business No. Employees ____
☐ Other ____


☐ Slab ☑ Crawl Space ☐ Basement w/plumbing ☐ Basement wo/plumbing

Water Supply: ☐ Individual ☐ Community ☒ Public

Comments: ① USE THREE FLOW DIVIDER TEES TO ACHIEVE EQUAL DISTRIBUTION INTO EACH OF FOUR LINES. ② INSTALL 52 CHAMBERS IN FOUR LINES AS SHOWN USING SAND TO FILL SIDEWALLS 6".

Comments:

INITIAL SITE SKETCH

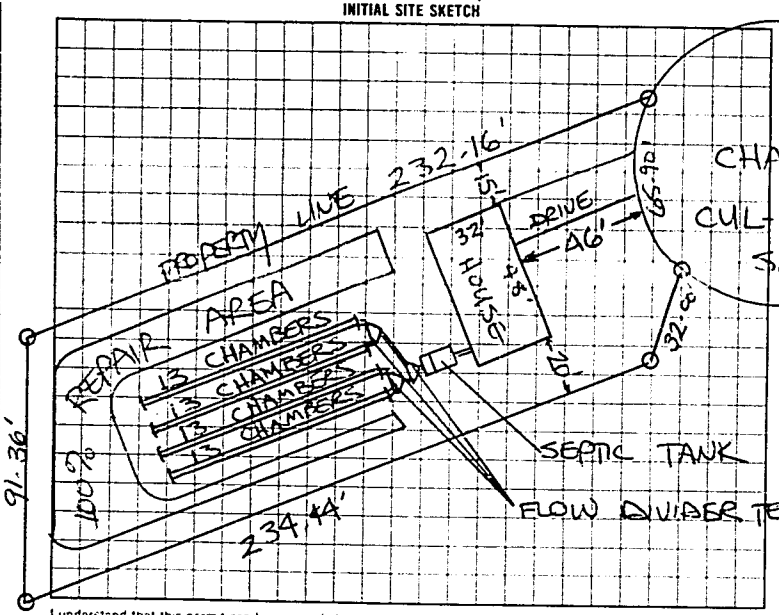

AS BUILT SKETCH

SYSTEM INSTALLED ACCORDING TO INITIAL SITE SKETCH

I understand that this permit can be suspended or revoked if any false information is supplied toward securing the permit, any unauthorized changes are made to the site, any unauthorized changes are made in the installation of the system

AUTHORIZATION TO CONSTRUCT IS VALID FIVE (5) YEARS FROM DATE OF ISSUANCE. IMPROVEMENT PERMIT HAS NO EXPIRATION DATE

Signed ____

Improvement Permit by STEVE HEDRICK date 2-26-96 Installed by A-1 BACKHOE

AUTHORIZATION TO CONSTRUCT

Existing System Inspection by STEVE HEDRICK date 2-26-96 ~~Certificate of Completion by~~ ____ date ____

Operation Permit by STEVE HEDRICK date 6-14-96

HEALTH DEPT COPY WHITE | INSPECTION COPY (INITIAL) GREEN | OWNER COPY (INITIAL) YELLOW | INSPECTION COPY (INITIAL) PINK | OWNER COPY (INITIAL) GOLD

104100