THIS PERMIT VOIDS PREVIOUS ISSUED 10-24-95 LOTS 20 & 21

IREDELL COUNTY HEALTH DEPARTMENT

STATESVILLE 704-878-5305 MOORESVILLE 704-664-5281

IMPROVEMENT PERMIT / CERTIFICATE OF COMPLETION / OPERATION PERMIT / EXISTING SYSTEM INSPECTION

PROPERTY DESCRIPTION NO CITY DATE 2-26-96 TAX MAP NO 6K-22-A-20 Watershed: ☐ Yes ☒ No

OWNER OR CONTRACTOR C. DOUGLAS MADISON PHONE: Business 871-1536 Home 873-0521

ADDRESS 1805 SAFRIET RD, STATESVILLE, N.C 28677

LOCATION NC 115 N TL OLD WILKESBORO ROAD, TR CANDLESTICK, TL CHALICE COURT, ON RIGHT AT END,

SUBDIVISION CANTERBURY BLOCK / SECTION II LOT 20 LOT AREA 1.9038 Ac SITE CLASS PS DESIGN FLOW 360 L.T.A.R. 0.30 GPD/FT²

Septic Tank: 1000 Gallons; STB 774 Date 2-26-96
Pump Tank: ____ Gallons; PT ____ Date ____
Pump Make ____ Model ____ Serial No ____
Nitrification Field No Fields 1 Square Feet 1200 Linear Feet 300+
No Lines 4 Trench Width 36" Max Trench Bottom Depth 24-36" Gravel Depth N/A

☒ New System ☐ Repair System Type: I II III IV V VI
System Description: CHAMBERED GRAVITY
Repair System Description: LPP REPAIR AREA
Maintenance Agreement Required Yes No


☒ House/Mod Home No Bedrooms 3
☐ Mobile Home No Bathrooms 2
☐ Business No Employees ____
☐ Other ____
Slab ☒ Crawl Space Basement w/plumbing Basement wo/plumbing

Water Supply
☐ Individual
☐ Community
☐ Public


Comments ① USE THREE FLOW DIVIDER TEES TO ACHIEVE EQUAL DISTRIBUTION INTO EACH OF FOUR LINES ② INSTALL FOUR LINES OF 13 CHAMBERS EACH (TOTAL = 52) AS SHOWN, MINIMUM 50' FROM BRANCH ③ USE SAND TO FILL 6" SIDEWALLS

Comments 59594

INITIAL SITE SKETCH

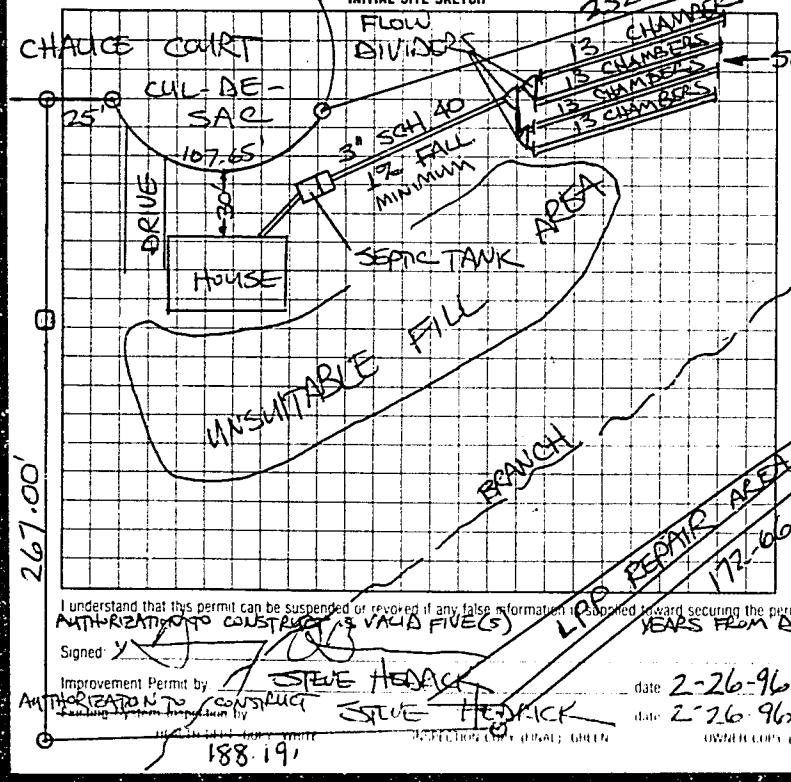

AS BUILT SKETCH

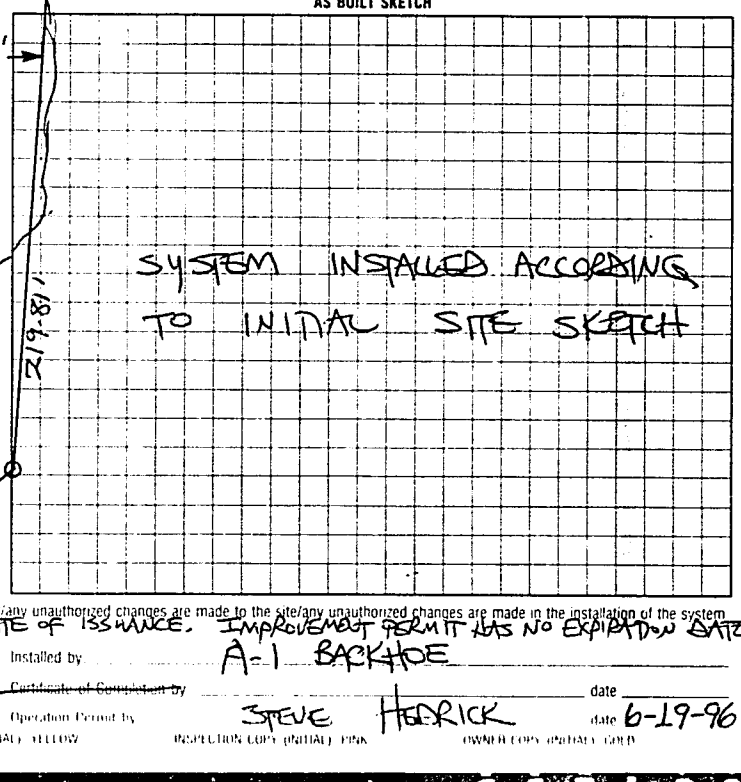

I understand that this permit can be suspended or revoked if any false information is supplied toward securing the permit, any unauthorized changes are made to the site, any unauthorized changes are made in the installation of the system AUTHORIZATION TO CONSTRUCT IS VALID FIVE(5) YEARS FROM DATE OF ISSUANCE. IMPROVEMENT PERMIT HAS NO EXPIRATION DATE.

Signed: ____

Improvement Permit by STEVE HEDRICK date 2-26-96 Installed by A-1 BACKHOE

AUTHORIZATION TO CONSTRUCT Issued by STEVE HEDRICK date 2-26-96 Certificate of Completion by ____ date ____

Existing System Inspection by ____ date ____ Operation Permit by STEVE HEDRICK date 6-19-96

INSPECTION COPY (FINAL) GREEN OWNER COPY (FINAL) YELLOW INSPECTION COPY (INITIAL) PINK OWNER COPY (INITIAL) GOLD

6621 00