THIS PERMIT VOIDS PREVIOUS ISSUED 10-24-95 LOTS 20 & 21

IREDELL COUNTY HEALTH DEPARTMENT

STATESVILLE 704-878-5305 MOORESVILLE 704-664-5281

IMPROVEMENT PERMIT / CERTIFICATE OF COMPLETION / OPERATION PERMIT / EXISTING SYSTEM INSPECTION

PROPERTY DESCRIPTION NO CITY DATE 2-26-96 TAX MAP NO. 6K-22-A-20 Watershed: ☐ Yes ☐ No

OWNER OR CONTRACTOR C. DOUGLAS MADISON PHONE: Business 871-1536 Home 873-0521

ADDRESS 1805 SAFRIET RD., STATESVILLE, N.C. 28677

LOCATION NC 115 N TL OLD WILKESBORO ROAD, TR CANDLESTICK, TL CHALICE COURT, ON RIGHT AT END.

SUBDIVISION CANTERBURY BLOCK / SECTION II LOT 20 LOT AREA 1.9038 Ac SITE CLASS. PS DESIGN FLOW 360 L.T.A.R. 0.30 GPD/FT²

Septic Tank: 1000 Gallons: ST# 794 Date 2-26-96
Pump Tank: _____ Gallons: PT _____ Date _____
Pump Make _____ Model EQUIVALENT Serial No _____
Nitrification Field No Fields 1 Square Feet 1200 Linear Feet 300+
No Lines 4 Trench Width 36" Max Trench Bottom Depth 24-36" Gravel Depth N/A

✓ New System Repair System Type: I II III IV V VI
System Description: CHAMBERED GRAVITY
Repair System Description: LPP REPAIR AREA
Maintenance Agreement Required Yes ~~No~~

✓ House/Mod Home No Bedrooms 3
Mobile Home No. Bathrooms 2
Business No Employees _____
Other _____


Slab ~~Crawl Space~~ Basement w/plumbing Basement wo/plumbing

Water Supply: ☐ Individual ☐ Community ☐ Public


Comments ① USE THREE FLOW DIVIDER TEES TO ACHIEVE EQUAL DISTRIBUTION INTO EACH OF FOUR LINES ② INSTALL FOUR LINES OF 13 CHAMBERS EACH (TOTAL = 52) AS SHOWN, MINIMUM 50' FROM BRANCH ③ USE SAND TO FILL 6" SIDEWALLS.

Comments 59594

INITIAL SITE SKETCH

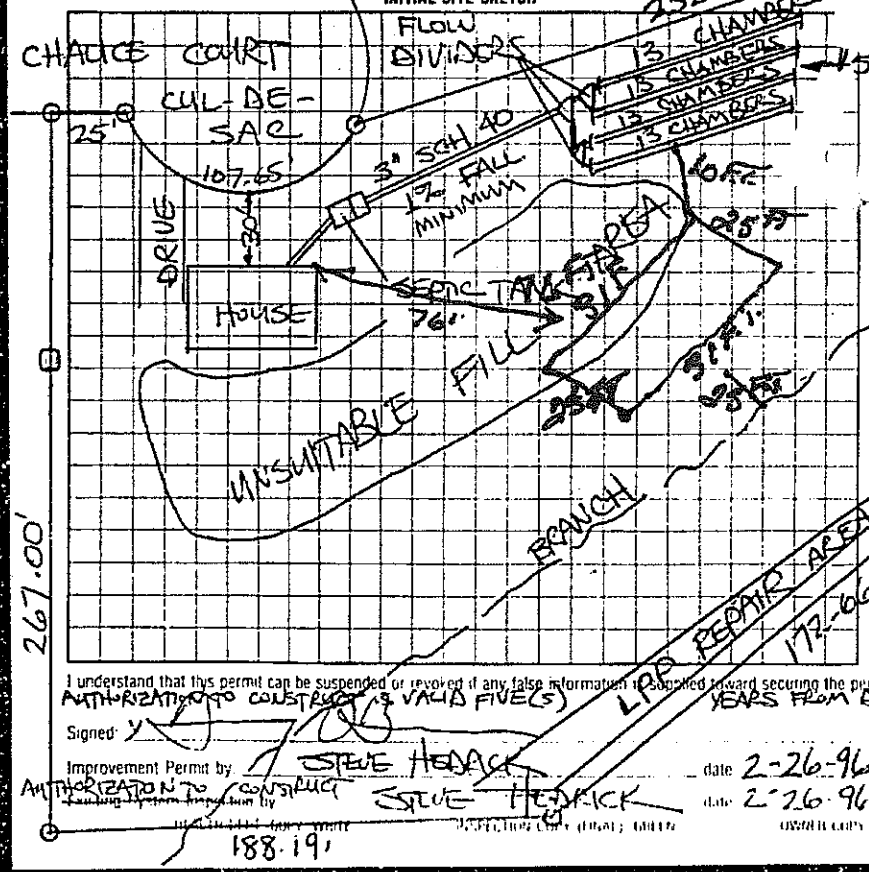

AS BUILT SKETCH

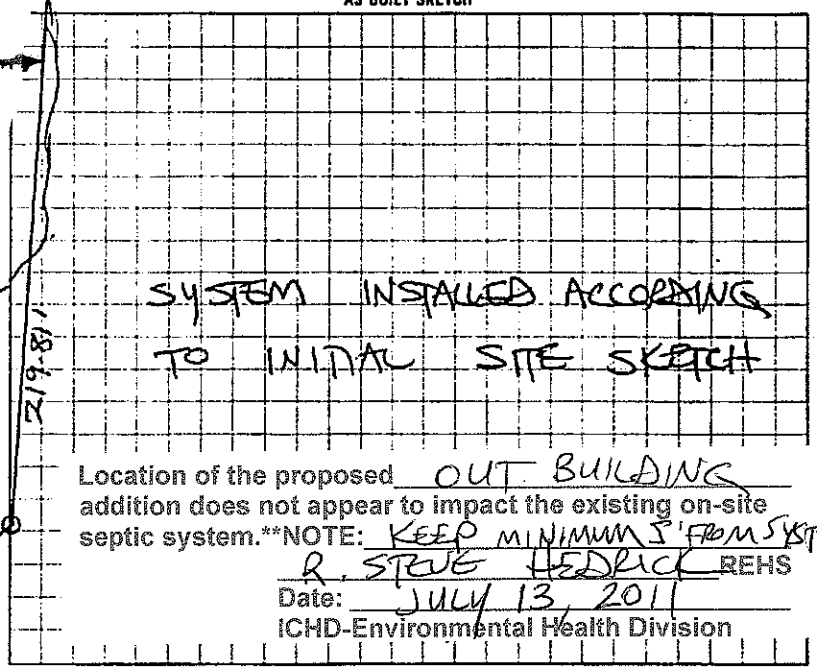

SYSTEM INSTALLED ACCORDING TO INITAL SITE SKETCH

Location of the proposed OUT BUILDING addition does not appear to impact the existing on-site septic system.**NOTE: KEEP MINIMUM 5' FROM SYSTEM

R. STEVE HEDRICK REHS
Date: JULY 13, 2011
ICHD-Environmental Health Division

I understand that this permit can be suspended or revoked if any false information is supplied toward securing the permit, any unauthorized changes are made to the site, any unauthorized changes are made in the installation of the system

AUTHORIZATION TO CONSTRUCT IS VALID FIVE(5) YEARS FROM DATE OF ISSUANCE. IMPROVEMENT PERMIT HAS NO EXPIRATION DATE.

Signed: _____

Improvement Permit by STEVE HEDRICK date 2-26-96 — Installed by A-1 BACKHOE

AUTHORIZATION TO CONSTRUCT Issued by STEVE HEDRICK date 2-26-96 — Certificate of Completion by _____ date _____

Operation Permit by STEVE HEDRICK date 6-19-96

INSPECTION COPY (FINAL) GREEN — OWNER COPY (FINAL) YELLOW — INSPECTION COPY (INITIAL) PINK — OWNER COPY (INITIAL) GOLD

662100