IREDELL COUNTY HEALTH DEPARTMENT

STATESVILLE 704-878-5305 MOORESVILLE 704-664-5281 57602

IMPROVEMENT PERMIT / CERTIFICATE OF COMPLETION / OPERATION PERMIT / EXISTING SYSTEM INSPECTION

PROPERTY DESCRIPTION NO. CITY DATE 8-11-95 TAX MAP NO. 6K-22-A-19 Watershed: ☐ Yes ☑ No

OWNER OR CONTRACTOR C@ DOUGLAS MADISON PHONE: Business 873-0521 Home 871-1536

ADDRESS 1805 SARIET ROAD STATESVILLE, NC 28677

LOCATION NC115N, TL OLD WILKESBORO RD, TR CANDLESTICK DR, ON LEFT AT CHALICE COURT

SUBDIVISION CANTERBURY BLOCK / SECTION II LOT 19 LOT AREA ~93X170 SITE CLASS. PS DESIGN FLOW 360 L.T.A.R. 0.3 GPD/FT²

Septic Tank: 1000 Gallons; STB 794 Date 11-22-95

Pump Tank: _____ Gallons; PT _____ Date _____

Pump Make: _____ Model EQUIVALENT Serial No. _____

Nitrification Field: No Fields 1 Square Feet 1200 Linear Feet 300

No Lines 4 Trench Width 36" Max Trench Bottom Depth 24-36" Gravel Depth N/A

☑ New System ☐ Repair System Type: I, II, III, IV, V, VI

System Description: GRAVITY-FED CHAMBERS

Repair System Description: GRAVITY-FED CHAMBERS

Maintenance Agreement Required: ☐ Yes ☑ No

☑ House/Mod. Home ☐ Mobile Home ☐ Business ☐ Other

No. Bedrooms 3 No. Bathrooms 2 No. Employees ____


☐ Slab ☑ Crawl Space ☐ Basement w/plumbing ☐ Basement wo/plumbing

Water Supply: ☐ Individual ☐ Community ☑ Public


Comments: INSTALL 50 CHAMBERS IN FOUR LINES AS SHOWN.

Comments:

INITIAL SITE SKETCH

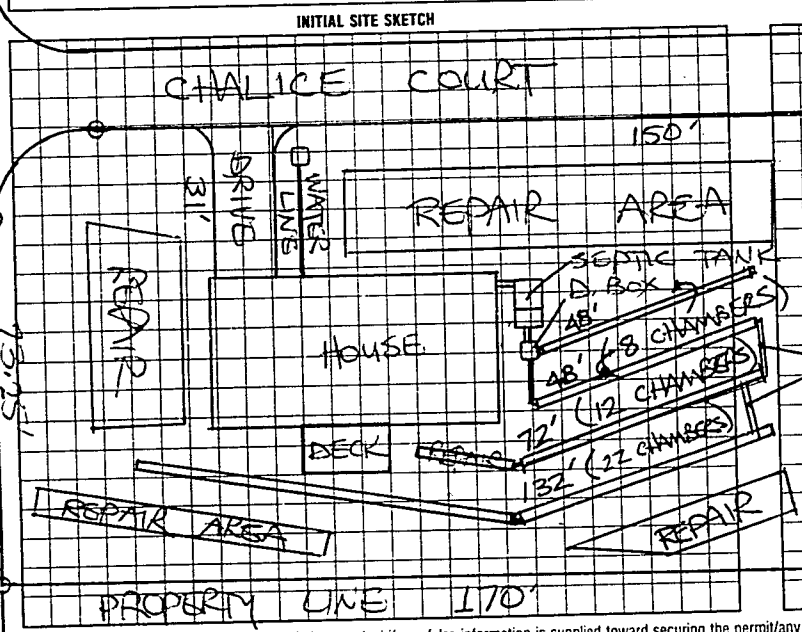

AS BUILT SKETCH

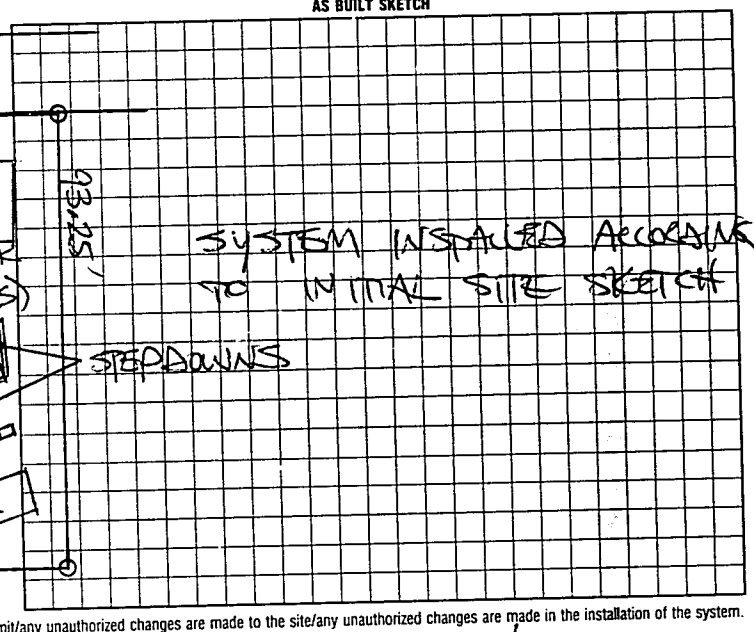

I understand that this permit can be suspended or revoked if any false information is supplied toward securing the permit/any unauthorized changes are made to the site/any unauthorized changes are made in the installation of the system.

Signed: [signature] Installed by: A-1 BACKHOE

Improvement Permit by: STEVE HENDRICK date 8-11-95 Certificate of Completion by: _____ date _____

Existing System Inspection by _____ date _____ Operation Permit by: STEVE HENDRICK date 1-22-96

HEALTH DEPT. COPY: WHITE INSPECTION COPY (FINAL): GREEN OWNER COPY (FINAL): YELLOW INSPECTION COPY (INITIAL): PINK OWNER COPY (INITIAL): GOLD

00129S