56920

IREDELL COUNTY HEALTH DEPARTMENT

STATESVILLE 704-878-5305 MOORESVILLE 704-664-5281

IMPROVEMENT PERMIT / CERTIFICATE OF COMPLETION / OPERATION PERMIT / EXISTING SYSTEM INSPECTION

PROPERTY DESCRIPTION NO. CITY DATE 7-31-95 TAX MAP NO. 6K-22-A-18 Watershed: ☐ Yes ☑ No

OWNER OR CONTRACTOR C. DOUGLAS MADISON PHONE: Business 871-1536 Home 873-0521

ADDRESS 1805 SAFRIET ROAD, STATESVILLE, NC 28677

LOCATION N C115 N, TL OLD WILKESBORO RD, TR CANDLESTICK DR, 2ND LOT ON LEFT BEFORE END

SUBDIVISION CANTERBURY BLOCK / SECTION II LOT 18 LOT AREA 88'x 170' SITE CLASS. PS DESIGN FLOW 360 L.T.A.R. 0.25 GPD/FT²

Septic Tank: 1000 Gallons; STB 794 Date 9-12-95

Pump Tank: _____ Gallons; PT _____ Date _____

Pump Make: _____ Model EQUIVALENT Serial No. _____

Nitrification Field: No Fields 1 Square Feet TO 1440 Linear Feet 240

No Lines 3 Trench Width 24" Max Trench Bottom Depth 32" STUB

Gravel Depth 6"

☑ New System ☐ Repair System Type: I, II, III, IV, V, VI

System Description: PPBPS GRAVITY-FED

Repair System Description: PPBPS GRAVITY-FED

Maintenance Agreement Required: ☐ Yes ☑ No

☑ House/Mod. Home No. Bedrooms 3

☐ Mobile Home No. Bathrooms 2

☐ Business No. Employees _____

☐ Other _____


☐ Slab ☐ Crawl Space ☐ Basement w/plumbing ☐ Basement wo/plumbing

Water Supply: ☐ Individual ☐ Community ☑ Public


Comments: INSTALL 55 PPBPS (PANELS) IN THREE TRENCHES AS SHOWN FOLLOWING MANUFACTURERS SPECIFICATIONS.

Comments:

INITIAL SITE SKETCH

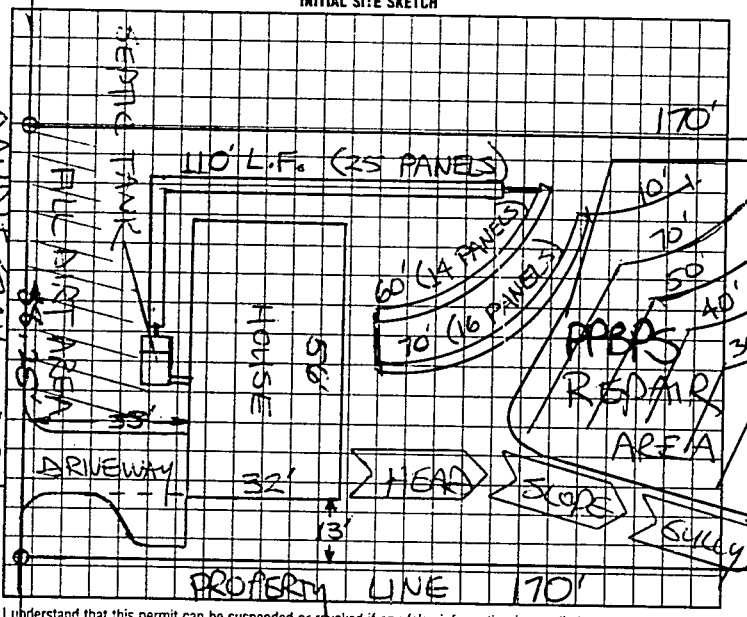

AS BUILT SKETCH

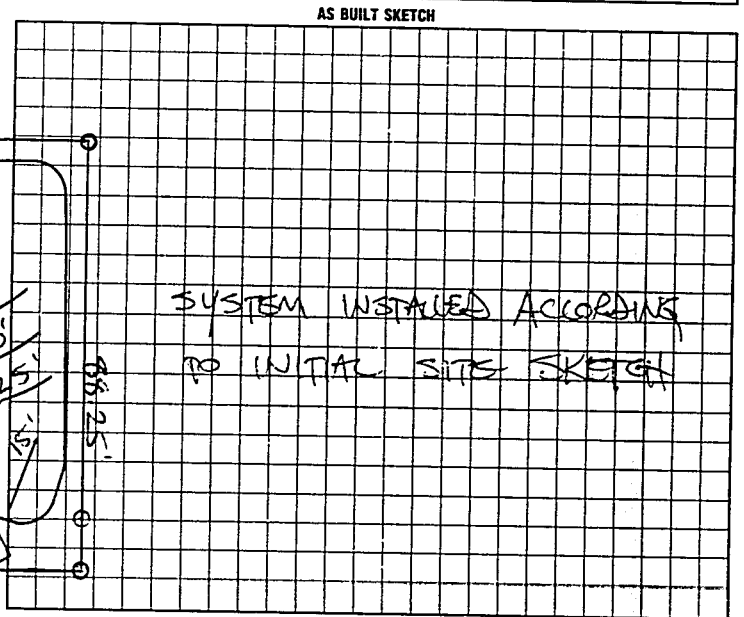

I understand that this permit can be suspended or revoked if any false information is supplied toward securing the permit/any unauthorized changes are made to the site/any unauthorized changes are made in the installation of the system.

Signed: Dick Cassada

Improvement Permit by: STEVE HEDRICK date 8-1-95

Existing System Inspection by: _____ date _____

Installed by: A-1 BACKHOE

Certificate of Completion by: _____ date _____

Operation Permit by: STEVE HEDRICK date 10/26/95

HEALTH DEPT. COPY: WHITE INSPECTION COPY (FINAL): GREEN OWNER COPY (FINAL): YELLOW INSPECTION COPY (INITIAL): PINK OWNER COPY (INITIAL): GOLD

622900