Crandall + O'Brien

53845

IREDELL COUNTY HEALTH DEPARTMENT

STATESVILLE 704-878-5305 MOORESVILLE 704-664-5281

IMPROVEMENT PERMIT / CERTIFICATE OF COMPLETION / OPERATION PERMIT / EXISTING SYSTEM INSPECTION

PROPERTY DESCRIPTION NO. CITY DATE 12/13/94 TAX MAP NO. 6K-22-A-25 Watershed: ☐ Yes ☑ No

OWNER OR CONTRACTOR C. DOUGLAS MADISON PHONE: Business 873-0521 Home

ADDRESS 1805 SAFRIET ROAD STATESVILLE NC 28677

LOCATION NC115N TL OLD WILKESBORO RD TR CANAL-STICK LOT ON LEFT AT CHALICE COURT

SUBDIVISION CANTERBURY BLOCK / SECTION I LOT 25 LOT AREA 92.80'x170' SITE CLASS. PS DESIGN FLOW 360 L.T.A.R. 0.36 GPD/FT²

Septic Tank: 1000 Gallons; STB 794 Date 12/13/94

Pump Tank: _____ Gallons; PT _____ Date _____

Pump Make: _____ Model _____ Serial No. _____

Nitrification Field: No Fields 1 Square Feet 1200 Linear Feet 300

No Lines 6 Trench Width 36" Max Trench Bottom Depth 24-36" Gravel Depth N/A

☑ New System ☐ Repair System Type: I, II, III, IV, V, VI

System Description: CHAMBERED GRAVITY

Repair System Description: CHAMBERED PUMP/GRAV

Maintenance Agreement Required: ☐ Yes ☑ No

☑ House/Mod. Home ☐ Mobile Home ☐ Business ☐ Other

No. Bedrooms 3 No. Bathrooms 2 No. Employees ____


☐ Slab ☑ Crawl Space ☐ Basement w/plumbing ☐ Basement wo/plumbing

Water Supply: ☐ Individual ☐ Community ☑ Public


Comments: ① INSTALL 50 CHAMBERS AS SHOWN USING SERIAL DISTRIBUTION ② FOLLOW MANUFACTURERS DIRECTIONS

Comments:

INITIAL SITE SKETCH

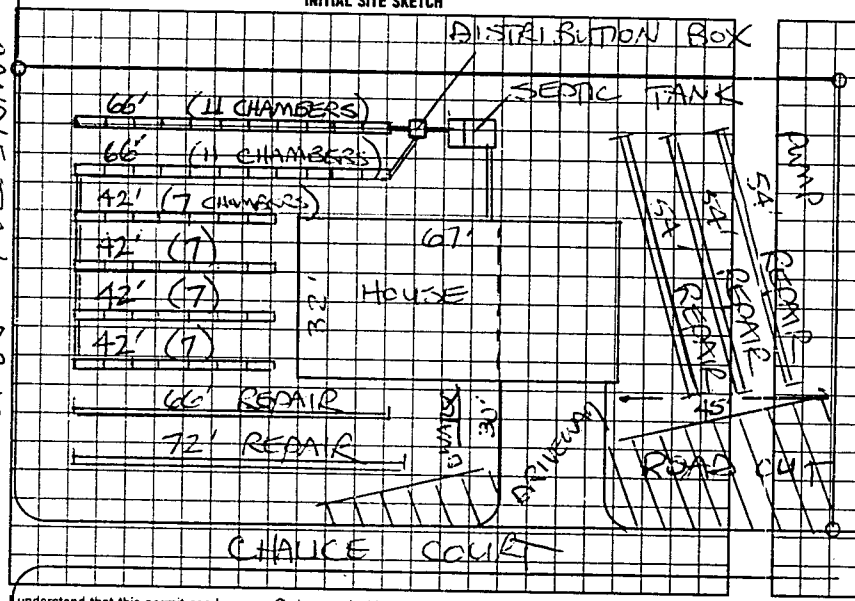

AS BUILT SKETCH

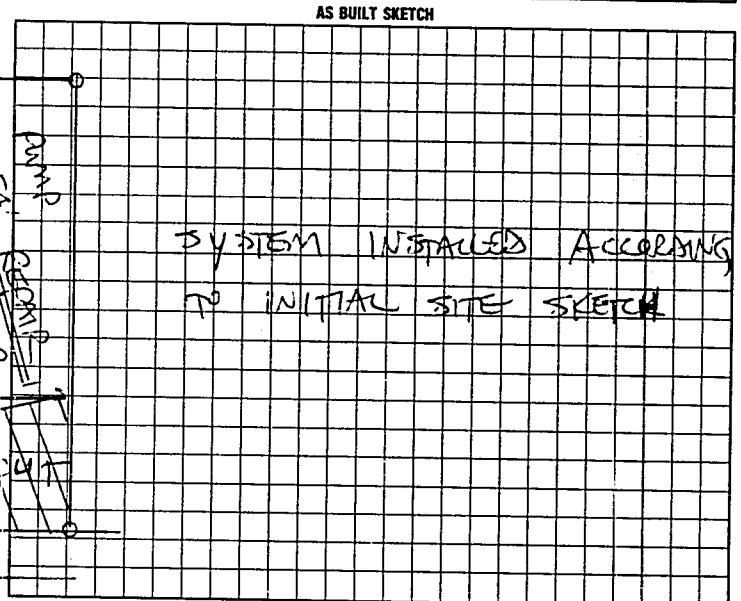

I understand that this permit can be suspended or revoked if any false information is supplied toward securing the permit/any unauthorized changes are made to the site/any unauthorized changes are made in the installation of the system. Improvement Permit is valid for 60 months from date of issuance.

Signed: _____

Improvement Permit by: STEVE HENDRICK date 12/15/94

Existing System Inspection by: _____ date _____

Installed by: A-1 BACKHOE

Certificate of Completion by: STEVE HENDRICK date 2/13/95

Operation Permit by: _____ date _____

HEALTH DEPT. COPY: WHITE INSPECTION COPY (FINAL): GREEN OWNER COPY (FINAL): YELLOW INSPECTION COPY (INITIAL): PINK OWNER COPY (INITIAL): GOLD

8 5 2 1 0 0