6K-22-A-14 on Computer

IREDELL COUNTY HEALTH DEPARTMENT

STATESVILLE 704-878-5305 MOORESVILLE 704-664-5281

IMPROVEMENT PERMIT / CERTIFICATE OF COMPLETION / OPERATION PERMIT / EXISTING SYSTEM INSPECTION

PROPERTY DESCRIPTION NO. CITY DATE 7-11-95 TAX MAP NO. 6K-22-A-15 14 Watershed: ☐ Yes ☒ No

OWNER OR CONTRACTOR C. D. MADISON PHONE: Business 871-4536 Home 873-0521

ADDRESS 1805 SAFRIET RD SVL NC 28677

LOCATION NC 115N TO OLD WILKESBORO, TR CANADESTICK, 14th LOT ON (R)

SUBDIVISION CANTERBURY BLOCK / SECTION II LOT 14 LOT AREA 100'X150' SITE CLASS. PS DESIGN FLOW 360 L.T.A.R. 0.3 GPA/FT

Septic Tank: 1000 Gallons; STB 794 Date 1-5-96

Pump Tank: _____ Gallons; PT _____ Date _____

Pump Make: _____ Model EQUIVALENT Serial No. _____

Nitrification Field: No Fields 1 Square Feet 288 Linear Feet 300

No Lines 4 Trench Width 36" Max Trench Bottom Depth 28-36" Gravel Depth N/A"

☒ New System ☐ Repair System Type: I, II, III, IV, V, VI

System Description: GRAVITY FED CHAMBERS

Repair System Description: PRESSURE PIPES

Maintenance Agreement Required: ☐ Yes ☒ No

☒ House/Mod. Home No. Bedrooms 3½

☐ Mobile Home No. Bathrooms ____

☐ Business No. Employees ____

☐ Other ____


☐ Slab ☒ Crawl Space ☐ Basement w/plumbing ☒ Basement wo/plumbing

Water Supply: ☐ Individual ☐ Community ☒ Public

Comments: ① KEEP SYSTEM MINIMUM 25' FROM BASEMENT FOUNDATION DRAIN (UPSLOPE-10") ② INSTALL 50 CHAMBERS IN FOUR LINES AS SHOWN.

Comments:

INITIAL SITE SKETCH

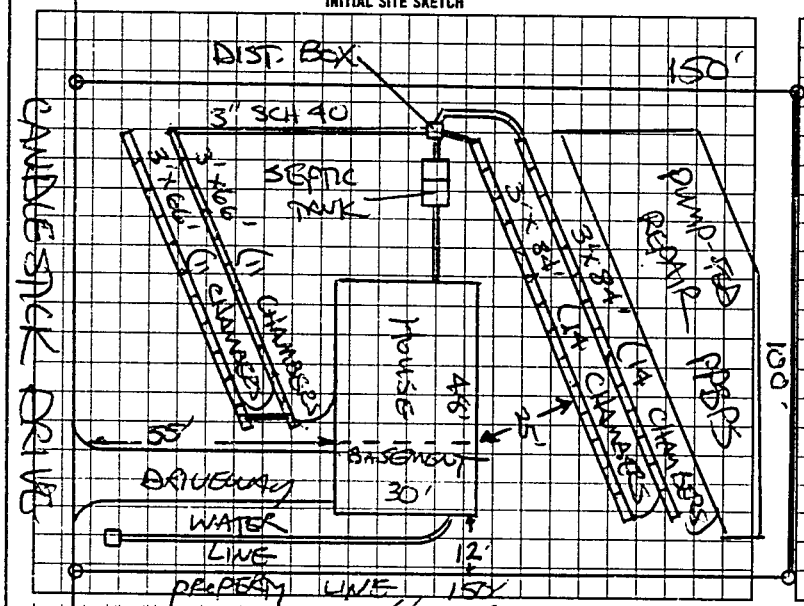

AS BUILT SKETCH

SYSTEM INSTALLED ACCORDING TO INITAL SITE SKETCH

I understand that this permit can be suspended or revoked if any false information is supplied toward securing the permit/any unauthorized changes are made to the site/any unauthorized changes are made in the installation of the system. Improvement Permit is valid for 60 months from date of issuance.

Signed: X

Improvement Permit by: STEVE HENRICK date 7-11-95

Existing System Inspection by: _____ date _____

Installed by: A-1 BACKHOE

Certificate of Completion by: _____ date _____

Operation Permit by: STEVE HENRICK date 2-19-96

HEALTH DEPT. COPY: WHITE INSPECTION COPY (FINAL): GREEN OWNER COPY (FINAL): YELLOW INSPECTION COPY (INITIAL): PINK OWNER COPY (INITIAL): GOLD