Crandall Bud Obrien

THIS PERMIT VOIDS PREVIOUS ISSUED 6-26-95 59986

IREDELL COUNTY HEALTH DEPARTMENT

STATESVILLE 704-878-5305 MOORESVILLE 704-664-5281

IMPROVEMENT PERMIT / CERTIFICATE OF COMPLETION / OPERATION PERMIT / EXISTING SYSTEM INSPECTION

PROPERTY DESCRIPTION NO. CITY DATE 12-1-95 TAX MAP NO. 6K-22-A-16 Watershed: ☐ Yes ☑ No

OWNER OR CONTRACTOR C. D. MADISON PHONE: Business 871-1536 Home 873-0521

ADDRESS 1805 SARRET RD STATESVILLE NC 28677

LOCATION NC 115 N TL OLD WILKESBORO HWY TR CANDLESTICK, LAST LOT ON RIGHT

SUBDIVISION CANTERBURY BLOCK / SECTION II LOT 16 LOT AREA 100' X 150' SITE CLASS P5 DESIGN FLOW 360 L.T.A.R. 0.3 GPD/FT²

Septic Tank: 1000 Gallons; STB 794 Date 2-15-96
Pump Tank: _____ Gallons; PT _____ Date _____
Pump Make: _____ Model EQUIVALENT Serial No. _____
Nitrification Field: No Fields 1 Square Feet 1250 Linear Feet 400
No Lines 6 Trench Width 36" Max Trench Bottom Depth 24-36" Gravel Depth N/A

☑ New System ☐ Repair System Type: I, II, III, IV, V, VI
System Description: CHAMBERED GRAVITY
Repair System Description: PDBDS PUMP
Maintenance Agreement Required: ☐ Yes ☑ No
☐ Slab ☑ Crawl Space ☐ Basement w/plumbing ☐ Basement wo/plumbing


☐ House/Mod. Home No. Bedrooms 3
☐ Mobile Home No. Bathrooms 2
☐ Business No. Employees ____
☐ Other _____

Water Supply:
☐ Individual
☐ Community
☑ Public

Comments: INSTALL 50 CHAMBERS AS SHOWN USING EQUAL DISTRIBUTION OUT OF DISTRIBUTION BOX, THEN SERIALLY OUT OF LINE #3 USING STEPDOWNS.

Comments:

INITIAL SITE SKETCH

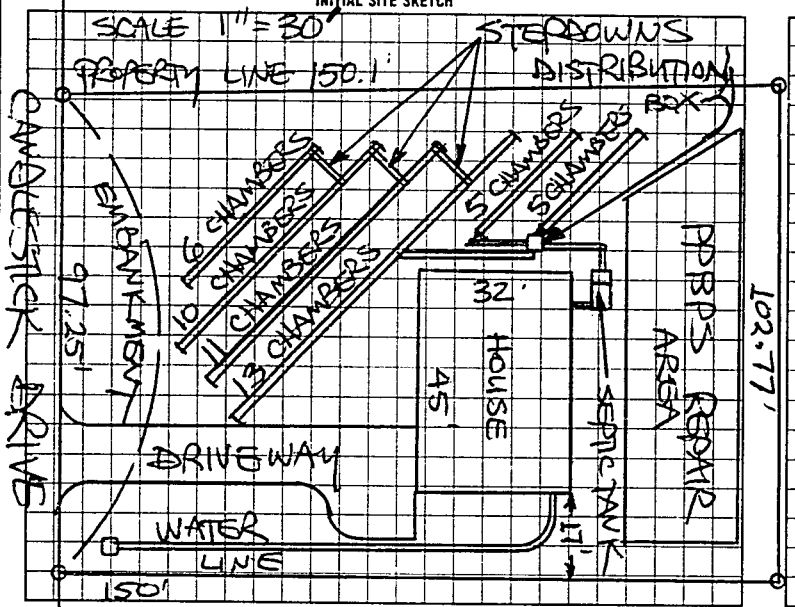

AS BUILT SKETCH

SYSTEM INSTALLED ACCORDING TO INITIAL SITE SKETCH

KEEP WATER LINE MINIMUM 10' FROM SYSTEM AS SHOWN

I understand that this permit can be suspended or revoked if any false information is supplied toward securing the permit/any unauthorized changes are made to the site/any unauthorized changes are made in the installation of the system.

AUTHORIZATION TO CONSTRUCT IS VALID FIVE (5) YEARS FROM DATE OF ISSUANCE. IMPROVEMENT PERMIT HAS NO EXPIRATION DATE.

Signed: _____

Improvement Permit by: STEVE HEDRICK date 12-1-96

Authorization to Construct by: STEVE HEDRICK date 12-1-95

Installed by: A-1 BACKHOE date _____

~~Certificate of Completion by:~~ _____ date _____

Operation Permit by: STEVE HEDRICK date 4-12-96

HEALTH DEPT COPY WHITE | INSPECTION COPY (FINAL) GREEN | OWNER COPY (FINAL) YELLOW | INSPECTION COPY (INITIAL) PINK | OWNER COPY (INITIAL) GOLD

S 8 2 1 0 0