Crandall + O'Brien

53257

IREDELL COUNTY HEALTH DEPARTMENT

STATESVILLE 704-878-5305 MOORESVILLE 704-664-5281

IMPROVEMENT PERMIT / CERTIFICATE OF COMPLETION / OPERATION PERMIT / EXISTING SYSTEM INSPECTION

PROPERTY DESCRIPTION NO. CITY DATE 10/7/94 TAX MAP NO. 6K-22-A-13 Watershed: ☐ Yes ☑ No

OWNER OR CONTRACTOR C. DOUGLAS MADISON PHONE: Business Home 873-0521

ADDRESS 1805 SARIET ROAD, STATESVILLE, NC 28677

LOCATION NC 115 N TL OLD WILKESBORO RD TR CANDLESTICK DR, 1ST LOT ON RIGHT

SUBDIVISION CANTERBURY BLOCK / SECTION LOT 13 LOT AREA 100' x 150' SITE CLASS. PS DESIGN FLOW 360 L.T.A.R. 0.336 GPD/FT

Septic Tank: 1000 Gallons; STB 794 Date 2/1/95

Pump Tank: Gallons; PT Date

Pump Make: Model Serial No.

Nitrification Field: No Fields 1 Square Feet 1030 Linear Feet 360

No Lines 4 Trench Width 36" Max Trench Bottom Depth 18-36" Gravel Depth 12"

☑ New System ☐ Repair System Type: I, II, III, IV, V, VI

System Description: CONV. GRAVITY

Repair System Description: CONV. GRAV/PUMP

Maintenance Agreement Required: ☐ Yes ☑ No

☑ House/Mod. Home No. Bedrooms 3

☐ Mobile Home No. Bathrooms 2

☐ Business No. Employees

☐ Other


☐ Slab ☑ Crawl Space ☐ Basement w/plumbing ☐ Basement wo/plumbing

Water Supply: ☐ Individual ☐ Community ☑ Public

Comments: SYSTEM MAY REQUIRE FUTURE SUBSURFACE INTERCEPT DRAIN DUE TO HEAD SLOPE LANDSCAPE POSITION

Comments:

INITIAL SITE SKETCH

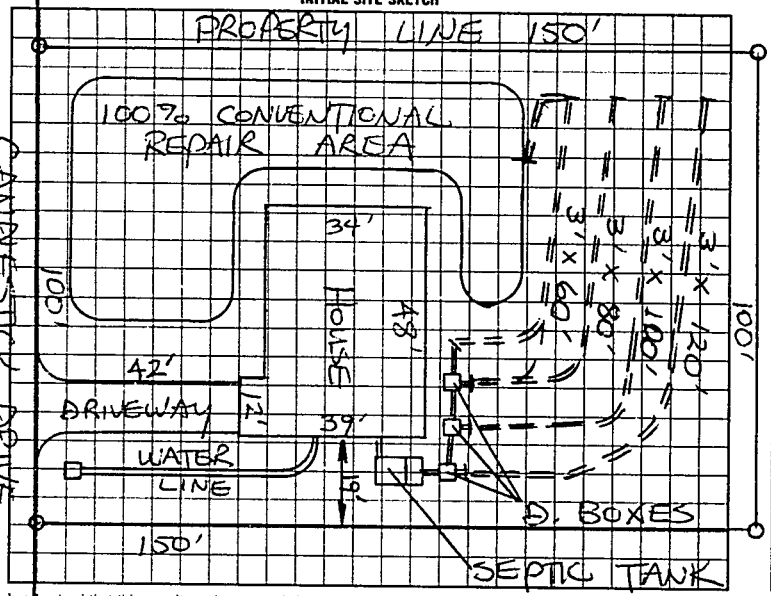

AS BUILT SKETCH

SYSTEM INSTALLED ACCORDING TO INITIAL SITE SKETCH

I understand that this permit can be suspended or revoked if any false information is supplied toward securing the permit/any unauthorized changes are made to the site/any unauthorized changes are made in the installation of the system. Improvement Permit is valid for 60 months from date of issuance.

Signed:

Improvement Permit by: STEVE HENDRICK date 10/7/94

Existing System Inspection by: date

Installed by: A-1 BACKHOE

Certificate of Completion by: STEVE HENDRICK date 3/22/95

Operation Permit by: date

HEALTH DEPT. COPY: WHITE INSPECTION COPY (FINAL): GREEN OWNER COPY (FINAL): YELLOW INSPECTION COPY (INITIAL): PINK OWNER COPY (INITIAL): GOLD

00125 3