IREDELL COUNTY HEALTH DEPARTMENT

STATESVILLE 704-878-5305 MOORESVILLE 704-664-5281

IMPROVEMENT PERMIT / AUTHORIZATION TO CONSTRUCT / OPERATION PERMIT / EXISTING SYSTEM INSPECTION

PERMIT# 116400 PIN# 4735 28 6578 DATE 9/29/05

OWNER OR CONTRACTOR JASON COLE PHONE: Business 704 657 8447 Home 704 871 0055

ADDRESS 105 GOLDEN OAK DR STATESVILLE, NC 28625

LOCATION HWY 115 S @ UPPER OAK DR @ GOLDEN OAK CORNER OF GOLDEN OAK AND UPPER OAK 105 GOLDEN OAK DR

SUBDIVISION MEADOW OAKS BLOCK / SECTION 2 LOT 61 LOT AREA .875 ACRES SITE CLASS. PS DESIGN FLOW 360GAD L.T.A.R. .35

Septic Tank: 1000 Gallons; STB 1012 Date 11/15/03
Pump Tank: ____ Gallons; PT ____ Date ____
Pump Make: ____ Model ____ Serial No. ____
Nitrification Field: No Fields 1 Square Feet 1029 Linear Feet 260
No Lines 4 Trench Width 36" Max Trench Bottom Depth 30" Gravel Depth NA

☐ New System ☐ Repair System Type: I, ☒ II, III, IV, V, VI
System Description: GRAVITY 25% REDUCTION
Repair System Description: LP PIPES
Maintenance Agreement Required: ☐ Yes ☒ No


☒ House/Mod. Home No. Bedrooms 3
☐ Mobile Home No. Bathrooms 2.5
☐ Business No. Employees ____
☐ Other ____
☐ Slab ☐ Crawl Space ☐ Basement w/plumbing ☒ Basement wo/plumbing

Water Supply: ☐ Individual ☒ Public ☐ Community


Comments:/Conditions:

Comments:/Conditions: KEEP POOL A MINIMUM OF 15' FROM SEPTIC LINES.

INITIAL SITE SKETCH

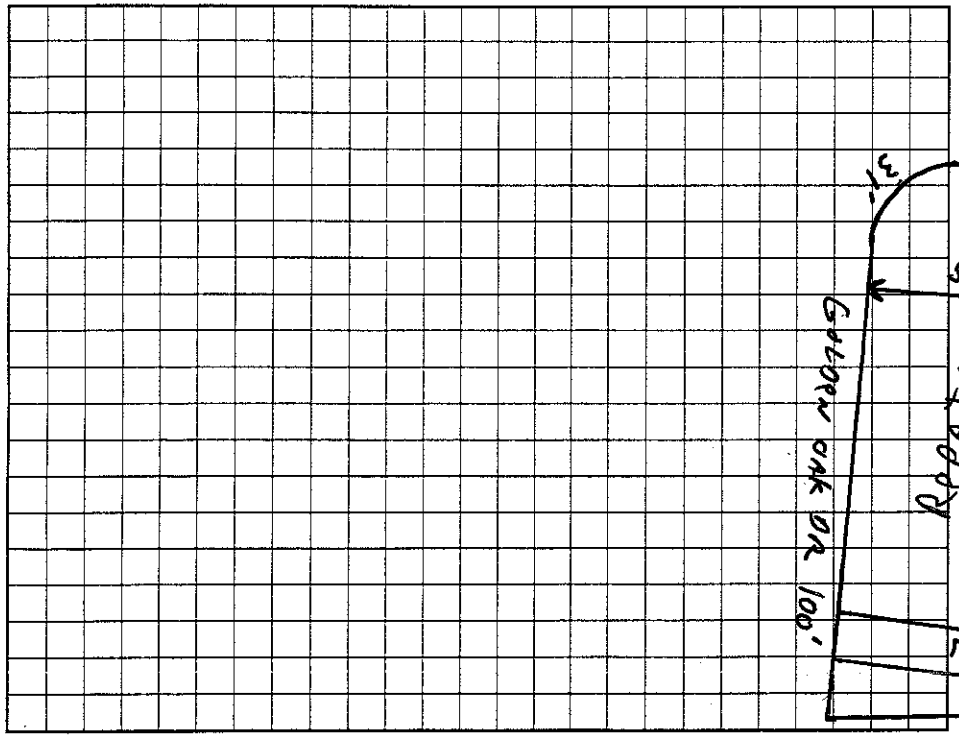

AS BUILT SKETCH

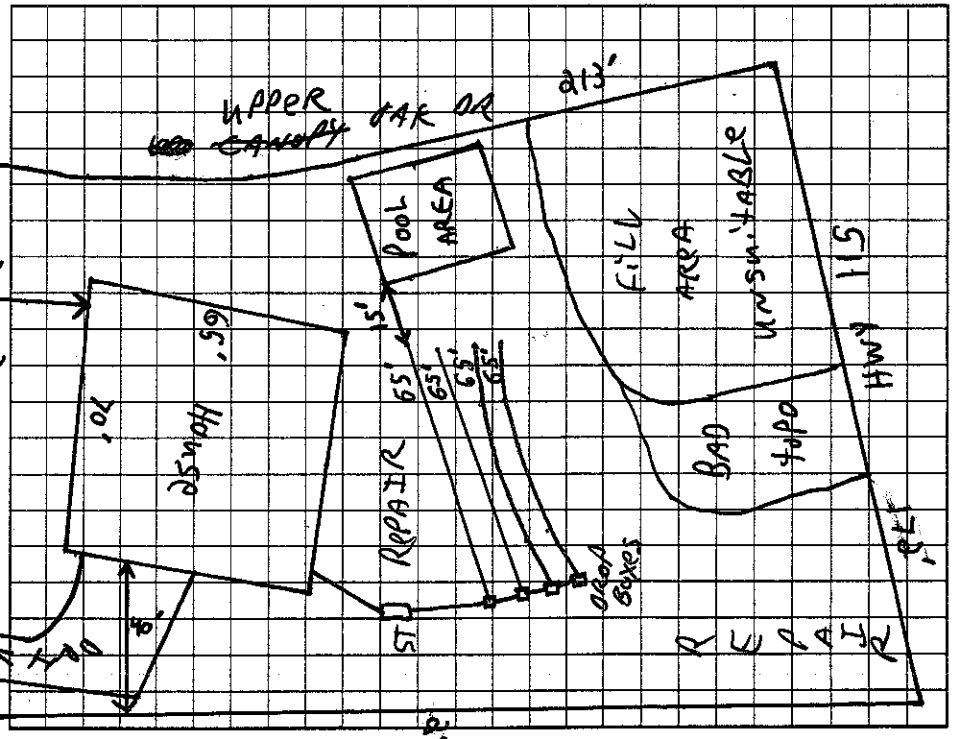

Permit can be suspended or revoked if any false information is supplied toward securing the permit/any unauthorized changes are made to the site/any unauthorized changes are made in the installation of the system. Improvement Permit with plat valid without expiration. Improvement Permit with site plan valid for sixty months. Authorization to Construct is valid for a period equal to that of Improvement Permit – not to exceed sixty months.

Signed: ____ date ____ Installed by: ____

Improvement Permit by: ____ date ____ Operation Permit by: ____ date ____

Authorization to Construct by: ____ date ____ Existing System Inspection by: [signature] date 9/29/05

HEALTH DEPT. COPY: WHITE OWNER COPY (FINAL): YELLOW OWNER COPY (INITIAL): PINK