IREDELL COUNTY HEALTH DEPARTMENT

STATESVILLE 704-878-5305 MOORESVILLE 704-664-5281

IMPROVEMENT PERMIT / AUTHORIZATION TO CONSTRUCT / OPERATION PERMIT / EXISTING SYSTEM INSPECTION

PERMIT# 120321 PIN# 4735-28-8376 DATE 6/24/04

OWNER OR CONTRACTOR Derek Osborne PHONE: Business 902-3084 Home (704) 872-7482

ADDRESS 3324 East Broad Street Statesville N.C. 28625

LOCATION 15 N. Right Upper Oak Drive 2nd lot on Right

SUBDIVISION Meadow Oaks BLOCK / SECTION 2 LOT 121 LOT AREA .73 Acres SITE CLASS. P5 DESIGN FLOW 360 L.T.A.R. .30

Septic Tank: 1000 Gallons; STB 1067 Date 10-29-04
Pump Tank: _____ Gallons; PT _____ Date _____
Pump Make: _____ Model _____ Serial No. _____
Nitrification Field: No Fields 1 Square Feet Eato 1200 Linear Feet 300
No Lines 4@75 Trench Width 36" Max Trench Bottom Depth 36" Gravel Depth NA

☒ New System ☐ Repair System Type: I, II, (III), IV, V, VI
System Description: Gravity, 25% Reduction
Repair System Description: Pump & Panel Block
Maintenance Agreement Required: ☐ Yes ☒ No


☒ House/Mod. Home No. Bedrooms 3
☐ Mobile Home No. Bathrooms 3
☐ Business No. Employees _____
☐ Other _____
☐ Slab ☐ Crawl Space ☒ Basement w/plumbing ☐ Basement wo/plumbing

Water Supply: ☒ Individual ☐ Public ☐ Community

Comments/Conditions: ① Install lines on contour ② maintain proper setbacks

Comments/Conditions: - Prior HO + contractor approval to move septic Tank
- Zabel Filter + ST Marker Installed
- Quick 4 Infiltrators Installed


INITIAL SITE SKETCH

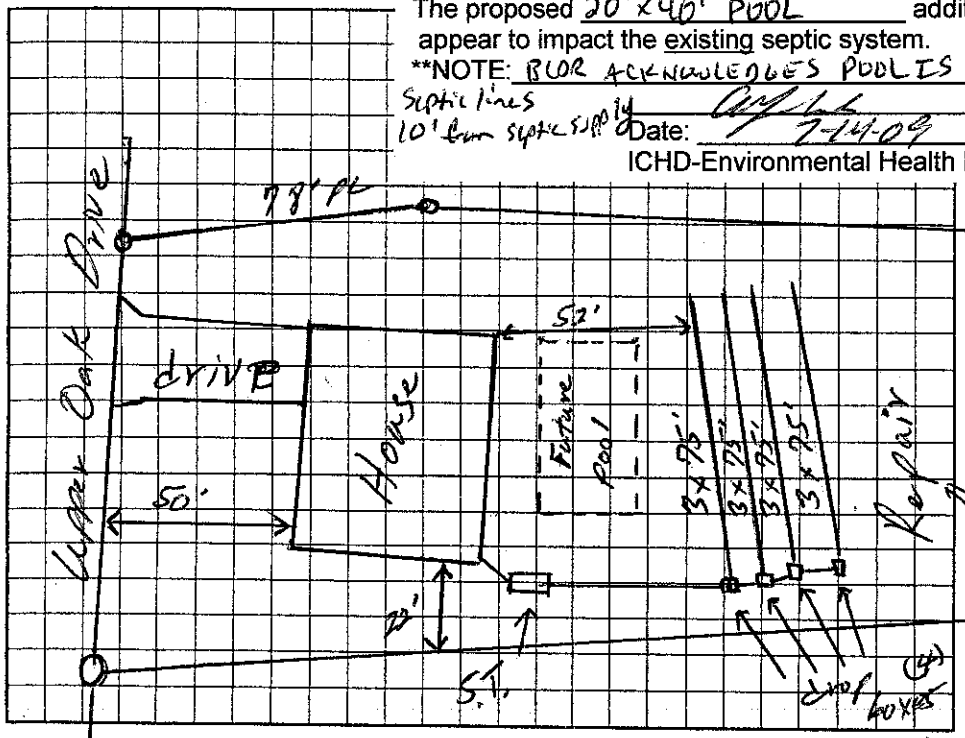

The proposed 20'x40' POOL addition does not appear to impact the existing septic system.
**NOTE: BOR ACKNOWLEDGES POOL IS 15' From Septic Lines 10' from septic supply
R.S.
Date: 7-14-04
ICHD-Environmental Health Division

AS BUILT SKETCH

SUB HAS NO FOUNDATION. DO NOT COVER any septic line or any part of system with SLAB FOR DECKING.

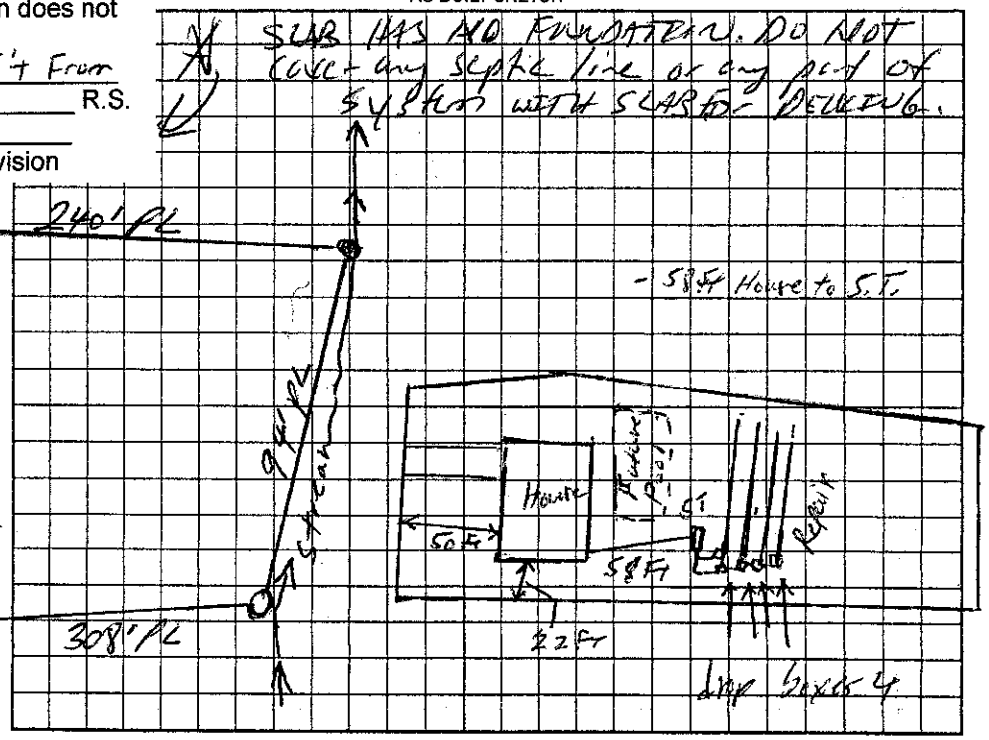

Permit can be suspended or revoked if any false information is supplied toward securing the permit/any unauthorized changes are made to the site/any unauthorized changes are made in the installation of the system. Improvement Permit with plat valid without expiration. Improvement Permit with site plan valid for sixty months. Authorization to Construct is valid for a period equal to that of Improvement Permit – not to exceed sixty months.

Signed: Derek Osborne date 6-24-04 Installed by: Sammy Shoemaker

Improvement Permit by: William O. Johnson date 6/24/04 Operation Permit by: William O. Johnson date 1/12/05

Authorization to Construct by: William O. Johnson date 6/24/04 Existing System Inspection by: _____ date _____

HEALTH DEPT. COPY: WHITE OWNER COPY (FINAL): YELLOW OWNER COPY (INITIAL): PINK