CA 4/3/08

IREDELL COUNTY HEALTH DEPARTMENT

STATESVILLE 704-878-5305 MOORESVILLE 704-664-5281

IMPROVEMENT PERMIT / AUTHORIZATION TO CONSTRUCT / OPERATION PERMIT / EXISTING SYSTEM INSPECTION

PERMIT# 144287 PIN# 4735-28-9618 DATE 8-1-07

OWNER OR APPLICANT MERLYN R. LONG PHONE: Business _____ Home 704-363-3643

ADDRESS 231 EAGLEWOOD ROAD, STATESVILLE NC 28625

LOCATION NC 115 NORTH, TR UPPER OAK DRIVE TL GOLDEN OAK DR 1ST LOT ON RIGHT

SUBDIVISION MEADOW OAKS BLOCK / SECTION II LOT 81 LOT AREA 0.737 ACRE SITE CLASS. PS DESIGN FLOW 360 L.T.A.R. 0.30 GPD/FT²

Septic Tank: 1000 Gallons: STB 1012 Date 4-20-07
Pump Tank: _____ Gallons; PT _____ Date _____
Pump Make: _____ Model _____ Serial No. _____
Nitrification Field: No Fields 1 Square Feet ~~1200~~ Linear Feet 200
No Lines FIVE Trench Width 24" Max Trench Bottom Depth 36" Min Depth 24"

☑ New System ☐ Repair ☐ Expansion System Type: I II (III) IV V VI
System Description: 50% REDUCTION, GRAVITY
Repair System Description: 50% REDUCTION, LOW PRESSURE
Maintenance Agreement Required: ☐ Yes ☑ No
☑ Gravity ☐ Pressure

☑ House/Mod. Home No. Bedrooms 3
☐ Mobile Home No. Persons ___
☐ Business No. Employees ___
☐ Other _____

☐ Slab ☑ Crawl Space ☐ Basement w/plumbing ☐ Basement wo/plumbing

Water Supply: ☐ Individual ☑ Public ☐ Community

Comments:/Conditions: (1) INSTALL 50% REDUCTION SYSTEM ON CONTOUR USING 45 PPBDS PANELS. (2) USE ONE EFFLUENT SPLITTER (SUCH AS ZOELLER) TO ACHIEVE EQUAL DISTRIBUTION INTO EACH LINE.

INITIAL SITE SKETCH

SEE ATTACHED "FAST TRACK" SITE PLAN PREPARED BY MICHAEL ATHANAS & ASSOC, INC.

Comments:/Conditions: (3) CLEAN OUT GULLY & FILL WITH GOOD FILL PRIOR TO ISSUANCE of AUTHORIZATION TO CONSTRUCT

AS BUILT SKETCH

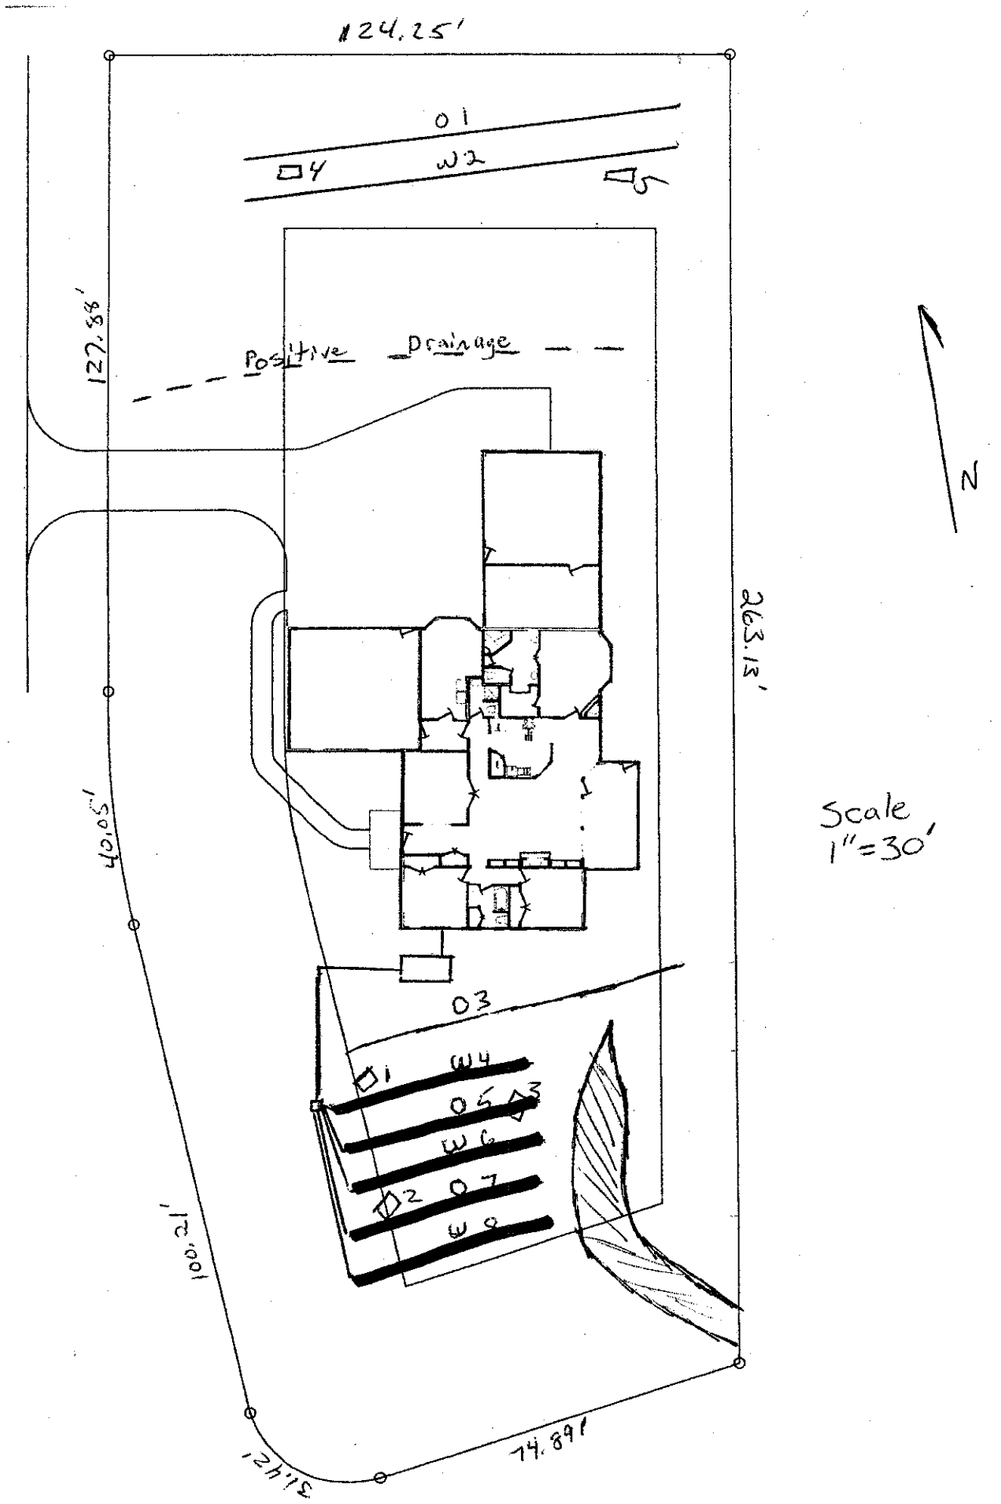
Permit can be suspended or revoked if any false information is supplied toward securing the permit/any unauthorized changes are made to the site/any unauthorized changes are made in the installation of the system. Improvement Permit with plat valid without expiration. ☐ Improvement Permit with site plan valid for sixty months. ☑ Authorization to Construct is valid for a period equal to that of Improvement Permit – not to exceed sixty months.

Signed: _____ date 08/01/07 Installed by: C & S Grading

Improvement Permit by: STEVE HEDRICK date 8-1-07 Operation Permit by: _____ date 4/2/08

Authorization to Construct by: STEVE HEDRICK date 8-10-07 Existing System Inspection by: _____ date _____

HEALTH DEPT. COPY: WHITE OWNER COPY (FINAL): YELLOW OWNER COPY (INITIAL): PINK


124.25'
01
04
W2
05
127.38'
Positive Drainage
263.13'
40.05'
03
01
W4
05
03
W6
02
07
W8
100.21'
14.89'
N

Scale
1"=30'