pd. #125 (VI)

IREDELL COUNTY HEALTH DEPARTMENT

STATESVILLE 704-878-5305 ✓ MOORESVILLE 704-664-5281

IMPROVEMENT PERMIT / AUTHORIZATION TO CONSTRUCT / OPERATION PERMIT / EXISTING SYSTEM INSPECTION

PERMIT# 087023 PIN# 4735 39 4457 DATE 3/12/01

OWNER OR CONTRACTOR K. W. Nicholson, Inc PHONE: Business (704) 876-4359 Home —

ADDRESS 182 Millstone Drive Statesville NC 28625

LOCATION Hwy 115 N ⓧ Upper Oak ⓛ Golden Oak on Left

SUBDIVISION Meadow Oaks BLOCK / SECTION # LOT 66 LOT AREA .67 Ac. SITE CLASS PS DESIGN FLOW 360 L.T.A.R. .3

Septic Tank: 4,000 Gallons: STB 1012 Date 7-29-01
Pump Tank: — Gallons: PT — Date —
Pump Make: — Model — Serial No. —
Nitrification Field: No Fields 1 Square Feet ~~691~~ 701,200 Linear Feet 200
No Lines 7 Trench Width 36" Max Trench Bottom Depth 36"

X New System ☐ Repair System Type: I II III IV V VI
System Description: 50% Reduction Pool Cover
Repair System Description: 25% Reduction Pump
Maintenance Agreement Required: ☐ Yes ☐ No
Gravel Depth SAND 6" ☐ Slab ☐ Crawl Space X Basement w/plumbing ☐ Basement wo/plumbing


X House/Mod. Home ☐ Mobile Home ☐ Business ☐ Other
No. Bedrooms 3 No. Bathrooms 2½ No. Employees —

Water Supply: ☐ Individual X Public ☐ Community


Comments/Conditions: ① Use 46 PVC PS pipe in 7 Lines ② Use One (1) flow divider with drop boxes ③ Keep System 10' from property lines & 15' from side of Gully

Comments/Conditions: — Poly-Lok Filter Installed — Septic Tank Risers Installed

INITIAL SITE SKETCH 1" = 40'

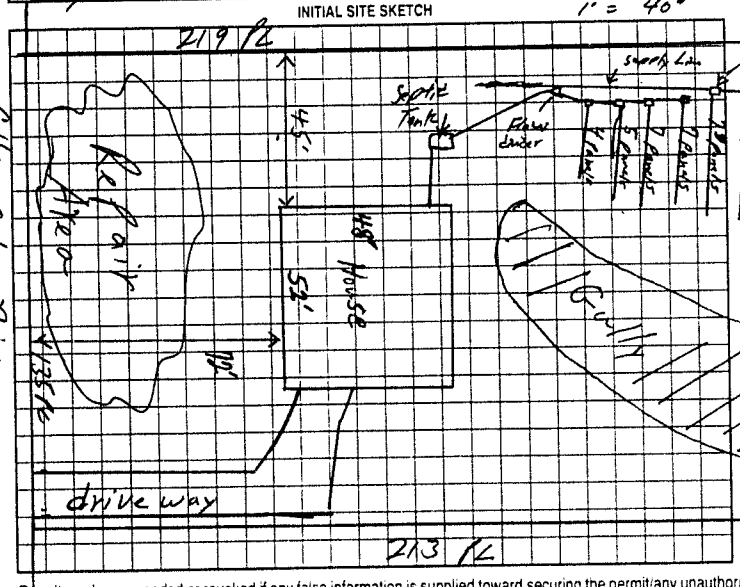

AS BUILT SKETCH

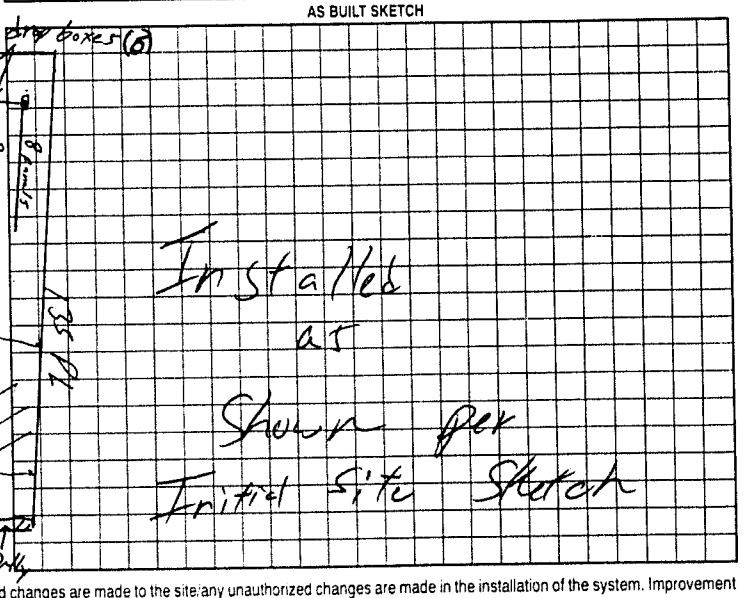

Golden Oak Drive

Permit can be suspended or revoked if any false information is supplied toward securing the permit/any unauthorized changes are made to the site/any unauthorized changes are made in the installation of the system. Improvement Permit with plat valid without expiration. Improvement Permit with site plan valid for sixty months. Authorization to Construct is valid for a period equal to that of Improvement Permit – not to exceed sixty months.

Signed: [signature] date 3-13-01 Installed by: David Spurtz

Improvement Permit by: William O. Johnson RSI date 3/13/01 Operation Permit by: William O. Johnson date 11/30/01

Authorization to Construct by: William O. Johnson RSI date 3/13/01 Existing System Inspection by: — date —

HEALTH DEPT COPY WHITE OWNER COPY (FINAL) YELLOW OWNER COPY (INITIAL) PINK