IREDELL COUNTY HEALTH DEPARTMENT

Statesville Phone TR 3-7271 — Mooresville Phone NO 3-1271

PERMIT TO INSTALL SEPTIC TANK

Permit NO. _____ Permit Date May 26 195 9

Owner Statesville Bible Church Address Hwy 115 & Chipley

Installed By C Hoke Address R 7.


Location of Property Corner of Chipley Ford Rd and Hwy 115 -

Tank		Capacity		Length of Lines		Fixtures	
Block	( )	800	(1)	150'	(2)	No. of Baths	(2)
Precast	(1)	900	( )	175'	( )	Dishwasher	( )
		1000	( )	200'	( )	Garbage Grdr.	( )
Leach		1100	( )	225'	( )	Auto-Washer	( )
		1200	( )	250'	( )	Other	
		Other		Other			

NOTIFY HEALTH DEPARTMENT AT LEAST EIGHT HOURS BEFORE TANK IS TO BE INSPECTED.

Final Inspection May 26 195 9 Approved ( ) Disapproved ( )

Remarks Self app by TCH. Well in front of church

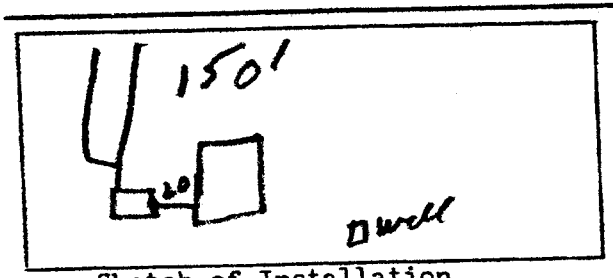

Sketch of Installation

R L Z

Sanitarian