IREDELL COUNTY HEALTH DEPARTMENT

STATESVILLE 704-878-5305 MOORESVILLE 704-664-5281

IMPROVEMENT PERMIT / AUTHORIZATION TO CONSTRUCT / OPERATION PERMIT / EXISTING SYSTEM INSPECTION

PERMIT# 134204 PIN# 4735-38-0382 DATE 3-16-06

OWNER OR CONTRACTOR JAMES DIEMICKE PHONE: Business Home 704-799-9090

ADDRESS 132 MEANDERING WAY LANE, MOORESVILLE NC 28117

LOCATION NC 115 NORTH, TR UPPER OAK DRIVE, 4TH LOT ON RIGHT

SUBDIVISION MEADOW OAKS BLOCK / SECTION II LOT 119 LOT AREA 0.931 ACRE SITE CLASS PS DESIGN FLOW 480 L.T.A.R. 0.25 GPD/FT²

Septic Tank: 1000 Gallons; STB 1012 Date 2-2-08

Pump Tank: Gallons; PT Date

Pump Make: Model EQ. TO Serial No.

Nitrification Field: No Fields 1 Square Feet 1920 Linear Feet 480

No Lines SIX Trench Width 36" Max Trench Bottom Depth 30" Gravel Depth

☑ New System ☐ Repair System Type: I II III IV V VI

System Description: 25% REDUCTION, GRAVITY

Repair System Description: LOW-PRESSURE PIPE

Maintenance Agreement Required: ☐ Yes ☑ No

☐ Slab ☐ Crawl Space ☐ Basement w/plumbing ☑ Basement wo/plumbing

☑ House/Mod. Home No. Bedrooms 4

☐ Mobile Home No. Bathrooms

☐ Business No. Employees


☐ Other

Water Supply: ☐ Individual ☑ Public ☐ Community


Comments:/Conditions: INSTALL 25% REDUCTION SYSTEM ON CONTOUR AS SHOWN, NO DEEPER THAN 30"

Comments:/Conditions:

INITIAL SITE SKETCH

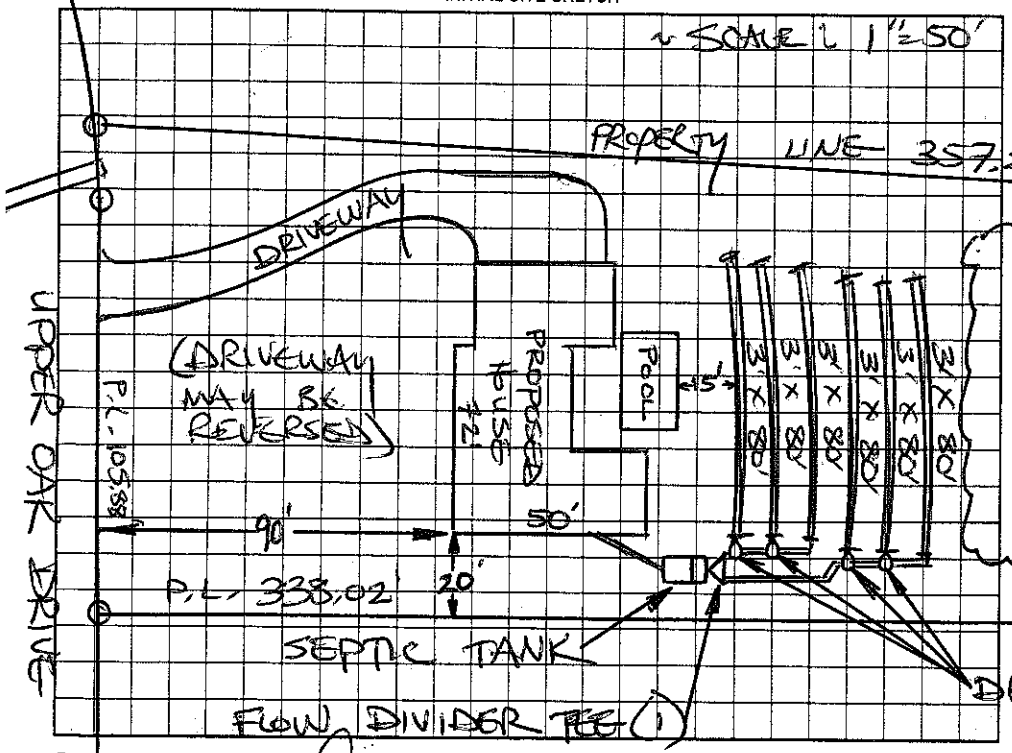

AS BUILT SKETCH

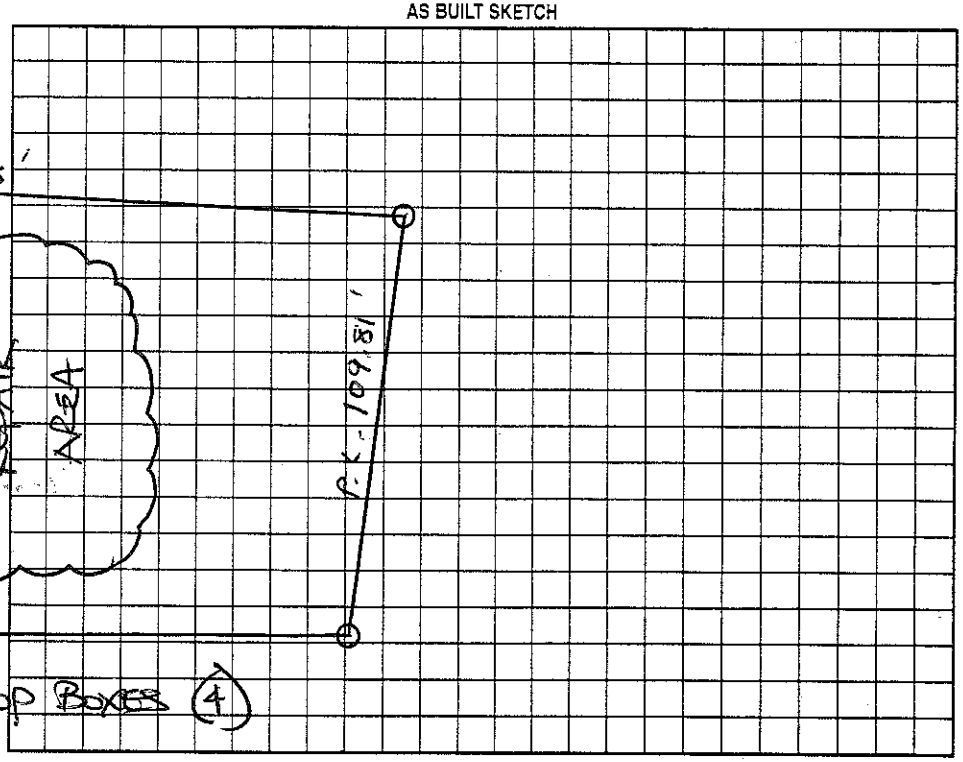

Permit can be suspended or revoked if any false information is supplied toward securing the permit/any unauthorized changes are made to the site/any unauthorized changes are made in the installation of the system. Improvement Permit with plat valid without expiration. Improvement Permit with site plan valid for sixty months. Authorization to Construct is valid for a period equal to that of Improvement Permit – not to exceed sixty months.

Signed: James Diemicke date 03-17-06 Installed by: Wintz Grading

Improvement Permit by: STEVE HEDRICK date 3-16-06 Operation Permit by: James date 3-9-09

Authorization to Construct by: STEVE HEDRICK date 3-16-06 Existing System Inspection by: date

HEALTH DEPT. COPY: WHITE OWNER COPY (FINAL): YELLOW OWNER COPY (INITIAL): PINK