Permit # 171559 attached for pool addition 3/2012.

IREDELL COUNTY HEALTH DEPARTMENT - ENVIRONMENTAL HEALTH ☒ STATESVILLE OFFICE 704-878-5305 ☐ MOORESVILLE OFFICE 704-664-5281

IMPROVEMENT PERMIT / AUTHORIZATION TO CONSTRUCT / OPERATION PERMIT / EXISTING SYSTEM INSPECTION @

PERMIT # 169084 PIN # 4735-38-[illegible] 0382 DATE 11-10-11

OWNER Stephen J. Ingram APPLICANT: Stikeleather Builders PHONE: Home/Cell # 704-871-7027 Business #

SITE ADDRESS 128 Upper Oak Dr. OWNER / APPLICANT ADDRESS

SITE DIRECTIONS 115N, past Rescue Squad Base (R) Upper Oaks Dr.; 4th house on right

SUBDIVISION Meadow Oaks BLOCK / SECTION LOT # 119 LOT AREA .931 Acre DESIGN FLOW 480 L.T.A.R. .25

Septic Tank Gallons: STB Date
Pump Tank Gallons: P T Date
Pump Make Model Serial #
No. Nitrification Fields: No. Lines Linear Feet
Trench Width Max. Trench Bottom Depth Gravel Depth


☐ New System ☐ Repair ☐ Expansion System Type I II III IV V VI
System Description:
Repair System Description:
Maintenance Agreement Required ☐ YES ☐ NO
☐ GRAVITY ☐ PRESSURE

☐ Residence No. Bedrooms
☐ Business No. Persons
☐ Other No. Employees
☐ Slab ☐ Crawl Space
☐ Basement w/plumbing ☐ Basement w/o plumbing


Water Supply
☐ Private
☐ Public
☐ Community

Comments / Conditions

INITIAL SITE SKETCH

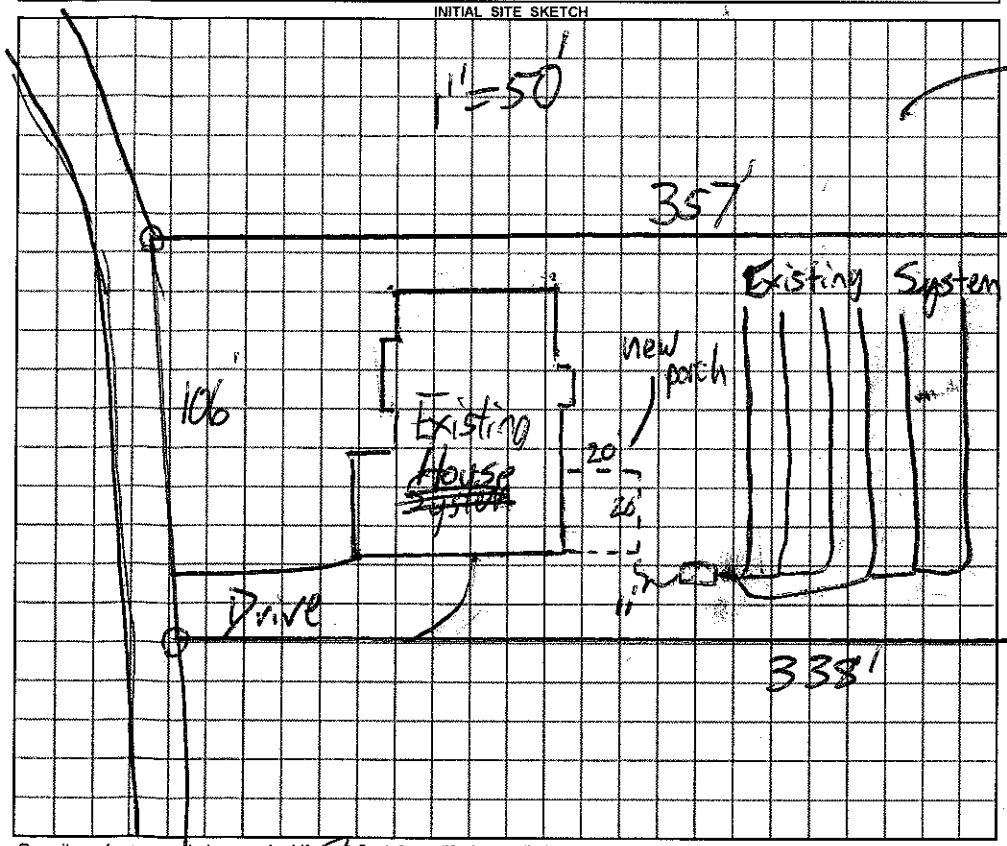

AS BUILT SKETCH

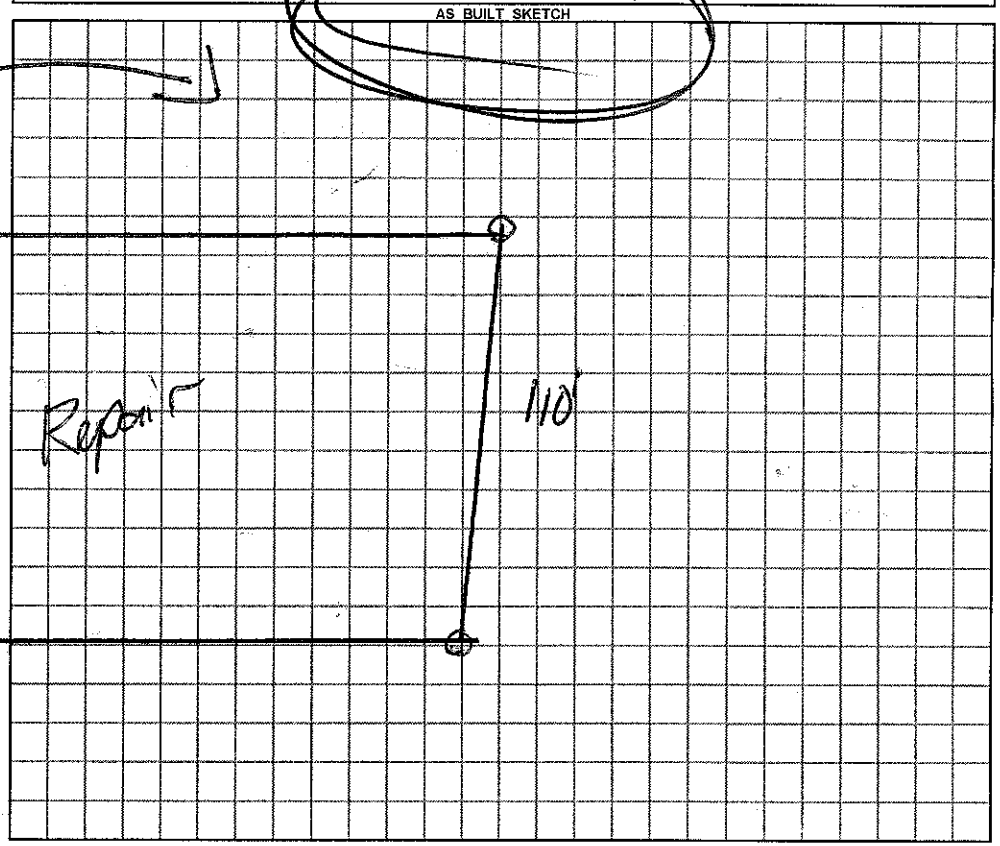

Permit can be suspended or revoked if any false information is supplied toward securing the permit / any unauthorized changes are made to the site / any unauthorized changes are made in the installation of the system.

☐ ***IMPROVEMENT PERMIT*** with plat valid without expiration. ☐ ***IMPROVEMENT PERMIT*** with plat valid without expiration. site plan valid 60 mo. ☐ ***AUTHORIZATION TO CONSTRUCT*** valid for period equal to IMPROVEMENT PERMIT--not to exceed 60 mo.

Owner / Applicant Signature: [signature] Date 11-14-11 Installed by:

IMPROVEMENT PERMIT by: REHS Date OPERATION PERMIT by: REHS Date

AUTHORIZATION TO CONSTRUCT by: REHS Date Existing System Inspected by: [signature] REHS Date 11-10-11

YOU SHOULD CONTACT A LOCATOR SERVICE PRIOR TO ANY EXCAVATION

White Copy -- Environmental Health YELLOW COPY (Final) Owner / Applicant PINK COPY (Initial) Owner / Applicant