This permit voids previously issued permit dated 4/22/03.

# IREDELL COUNTY HEALTH DEPARTMENT

STATESVILLE 704-878-5305 MOORESVILLE 704-664-5281

## IMPROVEMENT PERMIT / AUTHORIZATION TO CONSTRUCT / OPERATION PERMIT / EXISTING SYSTEM INSPECTION

PERMIT# 111937 PIN# 4735-38-0919 DATE 5/2/03

OWNER OR CONTRACTOR Wayne Horne PHONE: Business (704) 872-0217 Home —

ADDRESS 130 Victory Lane Statesville N.C 28625

LOCATION Hwy 115 N @ upper Oak, L on Golden Oak 3rd lot on left

SUBDIVISION Meadow Oaks BLOCK / SECTION II LOT 79 LOT AREA .592 Ac SITE CLASS. P5 DESIGN FLOW 480 L.T.A.R. .25 gpd/ft²

Septic Tank: 4000 Gallons; STB 312 Date 7-1-03

Pump Tank: 4000 Gallons; PT 283 Date 6-30-03

Pump Make: Goulds Model WE03111M Serial No.

Nitrification Field: No Fields 1 Square Feet 1440 Linear Feet 480

No Lines 6 @ 80' Trench Width 36" Max Trench Bottom Depth 30" Gravel Depth —

☒ New System ☐ Repair System Type: I, II, III, IV, V, VI

System Description: Pump, 25% Reduction

Repair System Description: Pump, low pressure

Maintenance Agreement Required: ☐ Yes ☒ No

☒ House/Mod. Home ☐ Mobile Home ☐ Business ☐ Other

No. Bedrooms 4 No. Bathrooms 2½ No. Employees


Water Supply: ☐ Individual ☒ Public ☐ Community

☐ Slab ☒ Crawl Space ☐ Basement w/plumbing ☐ Basement wo/plumbing

Comments:/Conditions:

Comments:/Conditions: - Zebra filter + ST Marker Installed
- Infiltrator Chambers Installed

INITIAL SITE SKETCH

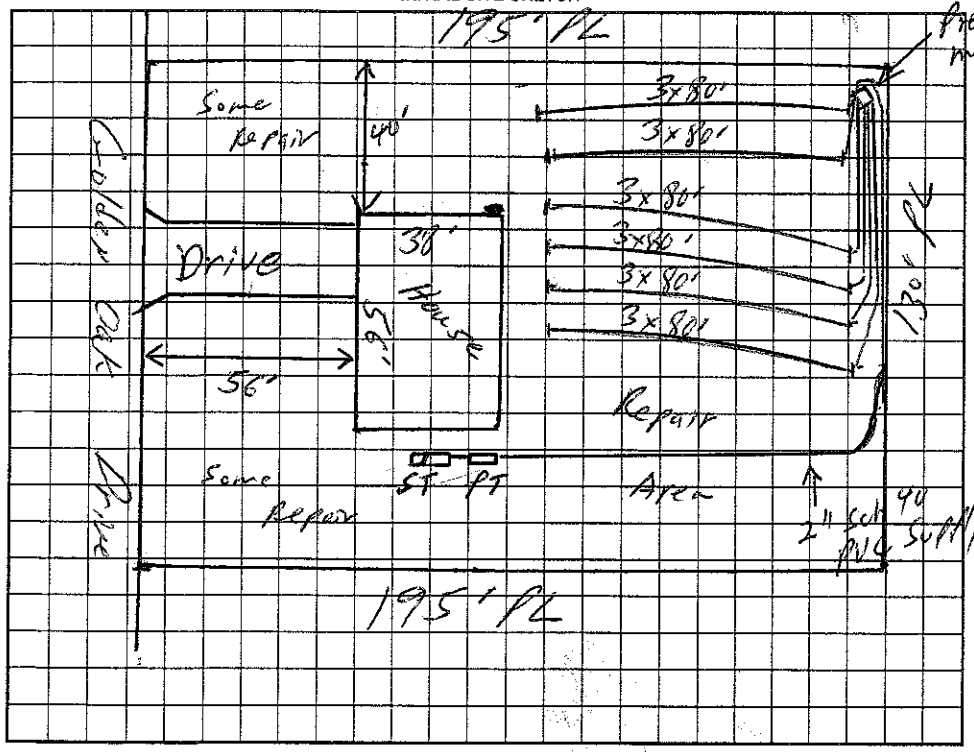


AS BUILT SKETCH

BILL JOHNSON CHECKED ABOVE. NEEDED 6 CHAMBERS ADDED & LOOKED LOOK V/D THE CHAMBERS ON 8-12-03 & SET THE PRESSURE. INSTALLED: 1 CHAMBER LINE 1
1 CHAMBER LINE 2
1 CHAMBER LINE 4
1 CHAMBER LINE 5
2 CHAMBERS LINE 6
NEEDS ELECTRICAL & RISER ON PUMP TANK.

Installed As Shown

Permit can be suspended or revoked if any false information is supplied toward securing the permit/any unauthorized changes are made to the site/any unauthorized changes are made in the installation of the system. Improvement Permit with plat valid without expiration. Improvement Permit with site plan valid for sixty months. Authorization to Construct is valid for a period equal to that of Improvement Permit – not to exceed sixty months.

Signed: [signature] date 7-21-03 Installed by: Marty Tucker

Improvement Permit by: William O. Johnson date 5/7/03 Operation Permit by: William O. John date 8/29/03

Authorization to Construct by: William O. Johnson date 5/7/03 Existing System Inspection by: _____ date _____

HEALTH DEPT. COPY: WHITE OWNER COPY (FINAL): YELLOW OWNER COPY (INITIAL): PINK