Nancy + Neil Goodman

IREDELL COUNTY HEALTH DEPARTMENT

STATESVILLE 704-878-5305 CI MOORESVILLE 704-664-5281

IMPROVEMENT PERMIT / AUTHORIZATION TO CONSTRUCT / OPERATION PERMIT / EXISTING SYSTEM INSPECTION

PERMIT# 106616 PIN# 4735-38-4966 DATE 3/6/03

OWNER OR CONTRACTOR Lon Earnhardt PHONE: Business (704) 902-8778 Home (704) 876-8202

ADDRESS 135 Big Oak Lane Statesville N.C. 28625

LOCATION Hwy 115 N. @ Upper Oak Lane, ~~Check Sets~~ on Right before Canopy Oak.

SUBDIVISION Meadow Oaks BLOCK / SECTION II LOT 113 LOT AREA .582 Ac. SITE CLASS. PS DESIGN FLOW 480 L.T.A.R. .30 gpd/ft²

Septic Tank: 1,000 Gallons; STB 1012 Date 3-9-03
Pump Tank: 1,000 Gallons; PT 17 Date 6-11-02
Pump Make: Goulds Model WE05512HHL Serial No. F0356313
Nitrification Field: No Fields 1 Square Feet 1600 Eqv. ft Linear Feet 270
No Lines 3@ 90' Trench Width 24" Max Trench Bottom Depth 36" ~~Gravel~~ Depth GAP-6"

☒ New System ☐ Repair System Type: I, II, III, (IV) V, VI
System Description: Pump, Low Pressure Panels
Repair System Description: Pump, Low Pressure Panels
Maintenance Agreement Required: ☒ Yes ☐ No


☒ House/Mod. Home No. Bedrooms 4
☐ Mobile Home No. Bathrooms 4
☐ Business No. Employees
☐ Other
☐ Slab ☐ Crawl Space ☒ Basement w/plumbing ☐ Basement wo/plumbing

Water Supply: ☐ Individual ☒ Public ☐ Community

Comments/Conditions: (1) Install 62 panels with ± 44½ tons of Sand (2) See attached sheets for pump and Low pressure distribution "A" & "B" (3) A contract shall be executed with a management entity prior to issuance of Operation Permit.

Comments/Conditions: (4) Maintain proper Setbacks
- Tuff-Tite Filter Installed + S.T. Risers.
- Liner inspected 10/17/03 - okay
- Control Value box installed.
- Pressure check

INITIAL SITE SKETCH Scale 1"=50'

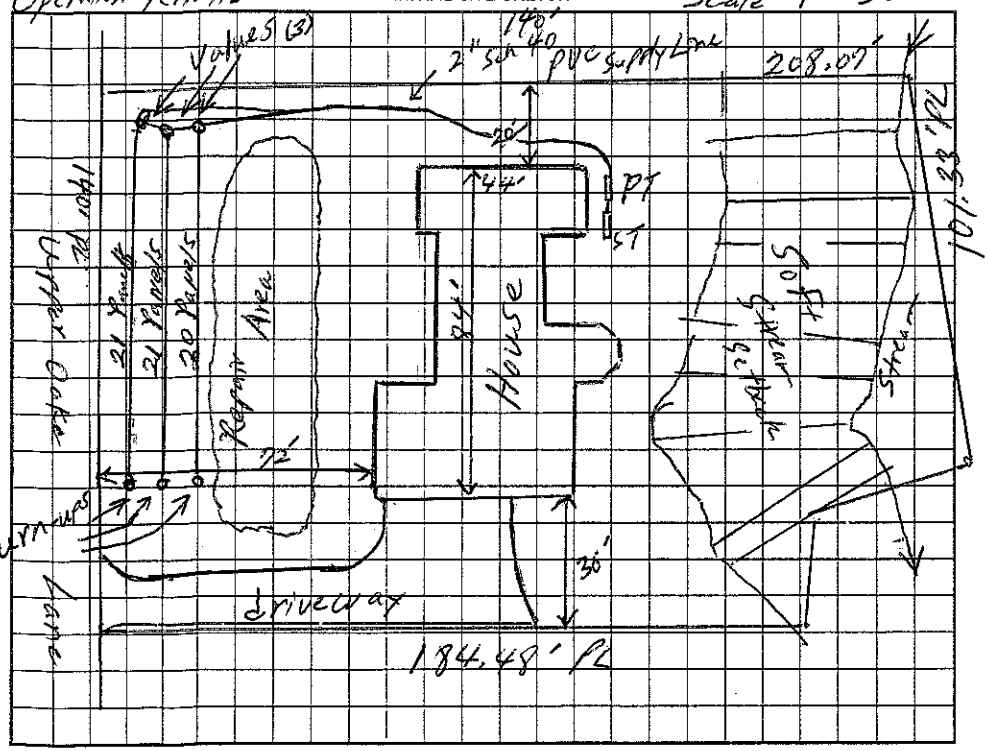

AS BUILT SKETCH

Installed as Shown per Initial Site Sketch

Permit can be suspended or revoked if any false information is supplied toward securing the permit/any unauthorized changes are made to the site/any unauthorized changes are made in the installation of the system. Improvement Permit with plat valid without expiration. Improvement Permit with site plan valid for sixty months. Authorization to Construct is valid for a period equal to that of Improvement Permit – not to exceed sixty months.

Signed: Lon Ann Earnhardt date 3/10/03 Installed by: David Yountz

Improvement Permit by: William O. Johnson date 3/10/03 Operation Permit by: William O. Johnson date 5/27/04

Authorization to Construct by: William O. Johnson date 3/10/03 Existing System Inspection by: date

HEALTH DEPT. COPY: WHITE OWNER COPY (FINAL): YELLOW OWNER COPY (INITIAL): PINK