Nancy + Neil Goodman

IREDELL COUNTY HEALTH DEPARTMENT

STATESVILLE 704-878-5305 CI MOORESVILLE 704-664-5281

IMPROVEMENT PERMIT / AUTHORIZATION TO CONSTRUCT / OPERATION PERMIT / EXISTING SYSTEM INSPECTION

PERMIT# 106616 PIN# 4735-38-4966 DATE 3/6/03

OWNER OR CONTRACTOR Lou Earnhardt PHONE: Business (704) 902-8778 Home (704) 876-8702

ADDRESS 135 Big Oak Lane Statesville N.C. 28625

LOCATION Hwy 115 N. to Upper Oak Lane, ~~Left~~ on Right before Canopy Oak.

SUBDIVISION Meadow Oaks BLOCK / SECTION II LOT 113 LOT AREA .582 Ac. SITE CLASS PS DESIGN FLOW 480 L.T.A.R. .30 gpd/ft²

Septic Tank: 1,000 Gallons; STB 1012 Date 3-9-03

Pump Tank: 1,000 Gallons; PT 17 Date 6-11-02

Pump Make: Gould's Model WE0512H1PH Serial No. F0356313

Nitrification Field: No Fields 1 Square Feet Eq. 1600 Linear Feet 270

No Lines 3 @ 90' Trench Width 24" Max Trench Bottom Depth 36" ~~Gravel~~ Depth ABD-6"

☒ New System ☐ Repair System Type: I, II, III, IV, V, VI

System Description: Pump, Low Pressure Panels

Repair System Description: Pump, Low Pressure Panels

Maintenance Agreement Required: ☒ Yes ☐ No

☒ House/Mod. Home ☐ Mobile Home ☐ Business ☐ Other


No. Bedrooms 4 No. Bathrooms 4 No. Employees ___

☐ Slab ☐ Crawl Space ☒ Basement w/plumbing ☐ Basement wo/plumbing

Water Supply: ☐ Individual ☒ Public ☐ Community

Comments/Conditions: (1) Install 62 panels with 2 44# tons of Sand (2) See attached sheets for Pump and Low pressure distribution "A" & "B" (3) A contract shall be executed with a management entity prior to issuance of Operation Permit.

INITIAL SITE SKETCH Scale 1"=50'

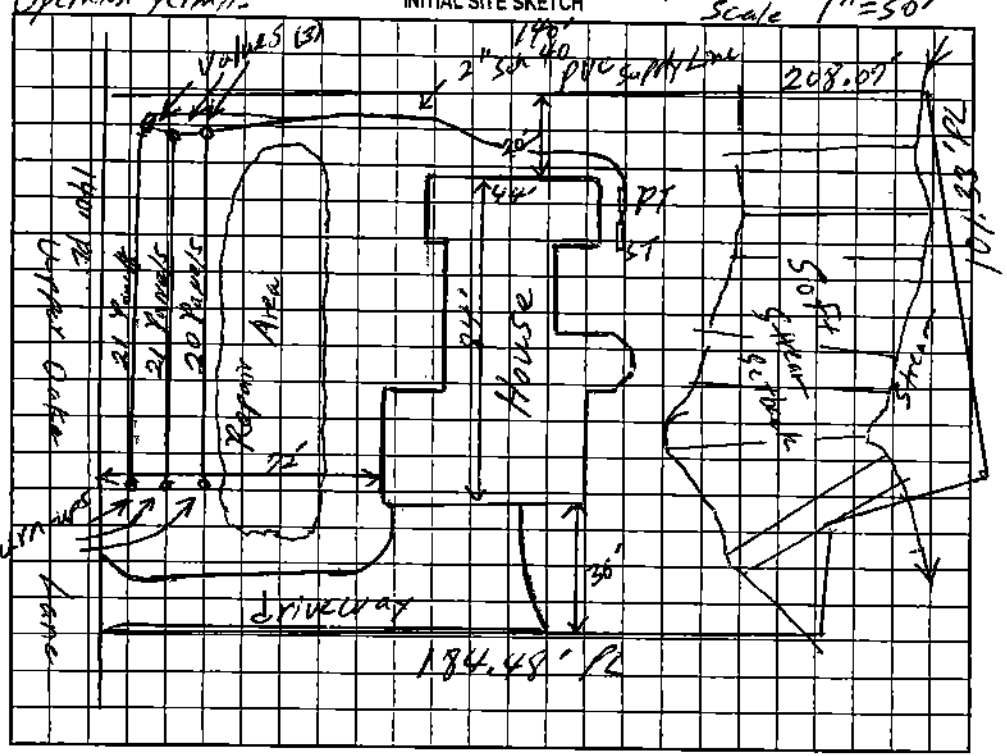

Comments/Conditions: (4) maintain proper setbacks
- Tuff-Tite Filter Installed & S.T. Risers.
- lines inspected 10/17/03 - okay
- Central Value Box installed.
- Pressure check

AS BUILT SKETCH

Installed as Shown per Initial Site Sketch

Permit can be suspended or revoked if any false information is supplied toward securing the permit/any unauthorized changes are made to the site/any unauthorized changes are made in the installation of the system. Improvement Permit with plat valid without expiration. Improvement Permit with site plan valid for sixty months. Authorization to Construct is valid for a period equal to that of Improvement Permit – not to exceed sixty months.

Signed: Lou Ann Earnhardt date 3/10/03

Improvement Permit by: William O. Johnson date 3/10/03

Authorization to Construct by: William O. Johnson date 3/10/03

Installed by: David Yount

Operation Permit by: William O. Johnson date 5/27/04

Existing System Inspection by: ___ date ___

HEALTH DEPT. COPY: WHITE OWNER COPY (FINAL): YELLOW OWNER COPY (INITIAL): PINK