IREDELL COUNTY HEALTH DEPARTMENT

STATESVILLE 704-878-5305 (C1) MOORESVILLE 704-664-5281

IMPROVEMENT PERMIT / AUTHORIZATION TO CONSTRUCT / OPERATION PERMIT / EXISTING SYSTEM INSPECTION

PERMIT# 107967 PIN# 4735-39-1510 DATE 8-13-02

OWNER OR CONTRACTOR ROBERT MANER PHONE: Business Home (704) 883-0801

ADDRESS 134 MULER CIRCLE APT. A, STATESVILLE, NC 28625

LOCATION NC 115 North, TR UPPER OAK, TL GOLDEN OAK, 7th LOT on RIGHT

SUBDIVISION MEADOW OAKS BLOCK / SECTION II LOT 75' LOT AREA 0.582 ACRE SITE CLASS. PS DESIGN FLOW 480 L.T.A.R. 0.40 GPD/FT²

Septic Tank: 1000 Gallons; STB 1012 Date 5-28-02
Pump Tank: _____ Gallons; PT _____ Date _____
Pump Make: _____ Model _____ Serial No. _____
Nitrification Field: No Fields 1 Square Feet 1200 Linear Feet 400
No Lines FIVE Trench Width 36" Max Trench Bottom Depth 36" Gravel Depth 12"

☑ New System ☐ Repair System Type: I (II) III, IV, V, VI
System Description: CONVENTIONAL, GRAVITY
Repair System Description: CONVENTIONAL, PUMP
Maintenance Agreement Required: ☐ Yes ☑ No


☑ House/Mod. Home No. Bedrooms 4
☐ Mobile Home No. Bathrooms 2
☐ Business No. Employees ____
☐ Other ____
☐ Slab ☑ Crawl Space ☐ Basement w/plumbing ☐ Basement wo/plumbing

Water Supply: ☐ Individual ☑ Public ☐ Community

Comments:/Conditions: KEEP SYSTEM MINIMUM 10 FEET FROM WATER LINE

Comments:/Conditions: ① SEPTIC TANK WITH MARKER INSTALLED USING "TUFTITE" FILTER
② SYSTEM INSTALLED DURING PERIOD OF WET SOIL CONDITIONS

INITIAL SITE SKETCH SCALE: 1"=40'

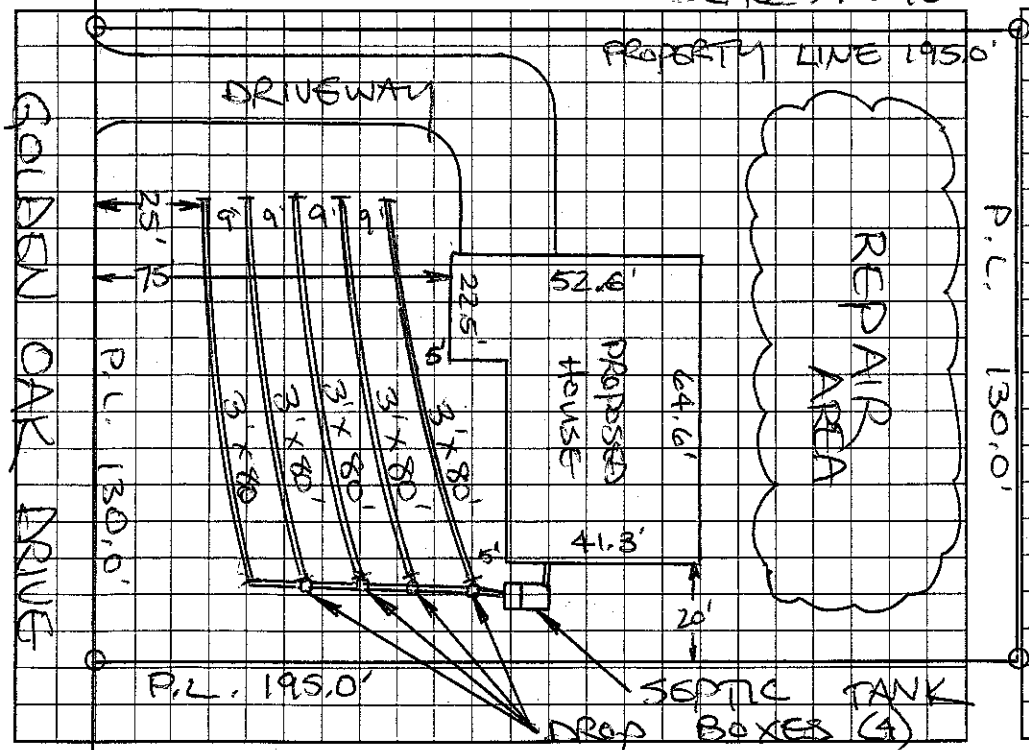

AS BUILT SKETCH

SYSTEM INSTALLED ACCORDING TO INITAL SITE SKETCH

Permit can be suspended or revoked if any false information is supplied toward securing the permit/any unauthorized changes are made to the site/any unauthorized changes are made in the installation of the system. Improvement Permit with plat valid without expiration. Improvement Permit with site plan valid for sixty months. Authorization to Construct is valid for a period equal to that of Improvement Permit – not to exceed sixty months.

Signed: X Robert D. Maner date 8-13-02 Installed by: TOMMY FRYE

Improvement Permit by: STEVE HEDRICK date 8-13-02 Operation Permit by: STEVE HEDRICK date 2-3-03

Authorization to Construct by: STEVE HEDRICK date 8-13-02 Existing System Inspection by: _____ date _____

HEALTH DEPT. COPY: WHITE OWNER COPY (FINAL): YELLOW OWNER COPY (INITIAL): PINK